



**RECEIVED**

**FEB 25 2020**

Town of Seabrook  
**SEWER DEPARTMENT**



DATE: 2/25/20

**APPLICATION FOR SEWER SERVICE**

APPLICANT / BUSINESS NAME CLAIRE Knowles

SERVICE ADDRESS 43 TRUE RD

MAP \_\_\_\_\_ LOT \_\_\_\_\_ SEQ. \_\_\_\_\_ ZONING DISTRICT \_\_\_\_\_ IS LOT IN CURRENT USE?  Y  N

MAILING ADDRESS 119 Lower Collins CITY SEABROOK STATE NH ZIP 03874

PHONE 603 944 0461 CELL \_\_\_\_\_ EMAIL Claireknowles57@icloud.com

PROPERTY OWNER (IF DIFFERENT THAN ABOVE) \_\_\_\_\_ PHONE \_\_\_\_\_

**TYPE OF CONSTRUCTION** (CHECK ALL THAT APPLY):

NEW CONSTRUCTION  RESIDENTIAL SINGLE-FAMILY \_\_\_\_\_ RESIDENTIAL MULTI-FAMILY \_\_\_\_\_  
 CONDO \_\_\_\_\_ MOBILE/MANUFACTURED HOME \_\_\_\_\_ COMMERCIAL \_\_\_\_\_ INDUSTRIAL \_\_\_\_\_  
 OTHER (PLEASE DESCRIBE): \_\_\_\_\_

BUILDING SIZE (IN SQUARE FEET) 768 sqft

COMMENTS (IF APPLICABLE PLEASE LIST NO. OF BUILDINGS AND NO. OF UNITS):  
 \_\_\_\_\_  
 \_\_\_\_\_  
 \_\_\_\_\_

**FIXTURE COUNT**

BATHROOM		KITCHEN		LAUNDRY		MISC	
SHOWER/TUB COMBO	<input checked="" type="checkbox"/>	SINKS	<input checked="" type="checkbox"/>	SINKS	<input checked="" type="checkbox"/>	WASHING MACHINE	<input type="checkbox"/>
BATHTUB	<input type="checkbox"/>	TOILETS	<input type="checkbox"/>	DISHWASHER	<input type="checkbox"/>	SINKS	<input type="checkbox"/>
SHOWER	<input type="checkbox"/>	URINALS	<input type="checkbox"/>	OTHER	<input type="checkbox"/>	OTHER	<input type="checkbox"/>
OVERSIZED BATHTUB (EX: JACUZZI, SOAKER)	<input type="checkbox"/>	BIDET	<input type="checkbox"/>				<input type="checkbox"/>
							<input type="checkbox"/>

PROPERTY OWNER SIGNATURE Claire Knowles DATE: 2-25-20

APPLICANT / CORPORATION OFFICER SIGNATURE \_\_\_\_\_ DATE: \_\_\_\_\_

CORPORATION NAME: \_\_\_\_\_

OFFICER'S NAME & TITLE (print) \_\_\_\_\_

I, Claire Knowles agree that I will not hold the Seabrook Sewer Department responsible for any damages to my property, which may be incurred during, or as a result of the sewer service installation.

Claire Knowles  
 Property Owner or Agent with Power of Attorney (Signature)

AMOUNT PAID \$800 CASH / CHECK # 6066 DATE RECEIVED 2/25/2020 BY JAM

**TOWN OF SEABROOK**  
**SEWER DEPARTMENT &**  
**WASTEWATER TREATMENT FACILITY**  
 PO BOX 456 • WRIGHT'S ISLAND • SEABROOK, NH 03874  
 PHONE (603) 474-8012 • FAX (603) 474-8014



**House Service Connection Ties**

Address: 43 TRVE ROAD  
 Map: 2-31 Lot: 19 Seq: \_\_\_\_\_

Please provide a sketch of the service connection with the approximate length. Please indicate the name of the street and a sketch of the house. In addition please show the approximate distances from any water lines on the property:

**Connection to Building**

The applicant shall provide proper plumbing of building(s), which shall be in compliance with the International Plumbing Code as well as the rules and ordinances of the Town of Seabrook and the State of New Hampshire. The Town of Seabrook shall inspect and certify the plumbing, including the underground piping (before backfilling), prior to connection to the Town of Seabrook's sewer system.

**--OFFICE USE ONLY--**

*Board of Sewer Commissioners*

GRANTED \_\_\_\_\_ DENIED \_\_\_\_\_ DATE \_\_\_\_\_

REASON FOR DENIAL: \_\_\_\_\_

\_\_\_\_\_  
(CHAIRMAN)

\_\_\_\_\_  
\_\_\_\_\_  
\_\_\_\_\_

*[Signature]* 2/26/2020  
 Sewer Superintendent Date

AMOUNT PAID \_\_\_\_\_ CASH / CHECK # \_\_\_\_\_ DATE RECEIVED \_\_\_\_\_ BY \_\_\_\_\_

43 TRVE Rd

EXISTING  
Driveway 18'

EXISTING  
Mobile

72'

ENTRY

ENTRY

UTILITY

DINING ROOM

BH

32

B ROOM

KITCHEN

PROPOSED  
MUDROOM

8

8 8

EXISTING  
Porch  
Common Hall

8

ENTRY

8

24

BATHROOM

EXISTING  
Porch

ENTRY  
16

8

4 Space Parking

TRVE lane

760 sqft

2/7

N/F  
ROY H. MULLIGAN, III  
44 TRUE ROAD  
SEABROOK, NH 03874  
BK.3608 PG.1733

2/8

N/F  
JERE A. & MARSHA J.  
32 TRUE ROAD  
SEABROOK, NH 03  
BK.2476 PG.03

EDGE OF PAVEMENT  
(TYPICAL)

TRUE

ROAD



I.P. FND.

C-2284

N 16°32'09" E  
149.94'  
(DEED 150')

1 ROD SET  
(11-2019)

AR  
FR  
FR  
SIL  
RE

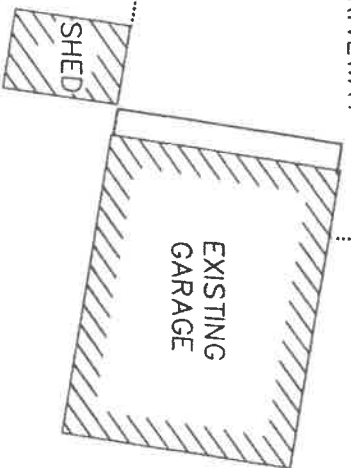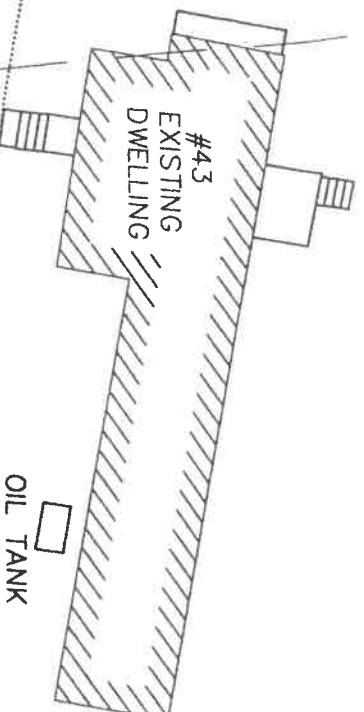

30,232. S.F.  
0.69 ACRES

2/19

199.51' TO I.P. FND.  
199.80' (DEED 200')  
N 75°23'11" W

S 75°15'18" E  
204.29'  
(DEED 200')

BUILDING SETBACK  
(TYPICAL)

P  
SEAL  
SCAL  
BY P  
C-22

JOHN JOSEPH  
SEAL  
BY

(DEED 150')  
149.69'  
C 104°42'21" W

307.21'

I.P. FND.

0.3'

OHWO

OHWO

EXISTING PAVED DRIVEWAY  
OHWO

1.3'

1.4'

12.9'