

Bob Merrill
603 502-7746

TOWN OF SEABROOK
SEWER DEPARTMENT &
WASTEWATER TREATMENT FACILITY
PO Box 456 • WRIGHT'S ISLAND • SEABROOK, NH 03874
PHONE (603) 474-8012 • FAX (603) 474-8014



APPLICATION FOR SEWER SERVICE

DATE: 5/12/20

APPLICANT / BUSINESS NAME Charles Merrill

SERVICE ADDRESS 3 Annes Ln Seabrook, NH 03874

MAP 14 LOT 25 SEQ. 2 ZONING DISTRICT _____ IS LOT IN CURRENT USE? Y/N (N)

MAILING ADDRESS 3 Cole St CITY Hampton STATE NH ZIP 03874

PHONE 603-502-7746 CELL same EMAIL ZIMA1957@Comcast.net

PROPERTY OWNER (IF DIFFERENT THAN ABOVE) _____ PHONE _____

TYPE OF CONSTRUCTION (CHECK ALL THAT APPLY):

NEW CONSTRUCTION RESIDENTIAL SINGLE-FAMILY _____ RESIDENTIAL MULTI-FAMILY _____

CONDO _____ MOBILE/MANUFACTURED HOME _____ COMMERCIAL _____ INDUSTRIAL _____

OTHER (PLEASE DESCRIBE): 3 Car detached garage

BUILDING SIZE (IN SQUARE FEET) 1200

COMMENTS (IF APPLICABLE PLEASE LIST NO. OF BUILDINGS AND NO. OF UNITS):

This request is to move the current sewer line location to within 5'-8' from home and hook up a soil pipe at new location for a 6x10 bathroom on a new construction 3 car garage (no second floor / built w/TWCSES)

FIXTURE COUNT

BATHROOM	KITCHEN	LAUNDRY	MISC
SHOWER/TUB COMBO <input type="checkbox"/>	SINKS <input type="checkbox"/>	WASHING MACHINE <input type="checkbox"/>	HOSEBIBS <input type="checkbox"/>
BATHTUB <input type="checkbox"/>	DISHWASHER <input type="checkbox"/>	SINKS <input type="checkbox"/>	BAR SINKS <input type="checkbox"/>
<u>SHOWER</u> <input type="checkbox"/>	OTHER <input type="checkbox"/>	OTHER <input type="checkbox"/>	POOL (SIZE) <input type="checkbox"/>
OVERSIZED BATHTUB (EX. JACUZZI, SOAKER) <input type="checkbox"/>			
SINKS <input type="checkbox"/>			
TOILETS <input type="checkbox"/>			
URINALS <input type="checkbox"/>			
BIDET <input type="checkbox"/>			

PROPERTY OWNER SIGNATURE _____ DATE: _____

APPLICANT / CORPORATION OFFICER SIGNATURE _____ DATE: _____

CORPORATION NAME: _____

OFFICERS NAME & TITLE (print) _____

I, Charles Merrill agree that I will not hold the Seabrook Sewer Department responsible for any damages to my property, which may be incurred during, or as a result of the sewer service installation.

Charles Merrill
Property Owner or Agent with Power of Attorney (Signature)

AMOUNT PAID _____ CASH / CHECK # _____ DATE RECEIVED _____ BY _____

TOWN OF SEABROOK
 SEWER DEPARTMENT &
 WASTEWATER TREATMENT FACILITY
 PO BOX 456 • WRIGHT'S ISLAND • SEABROOK, NH 03874
 PHONE (603) 474-8012 • FAX (603) 474-8014



House Service Connection Ties

Address: 3 Ames Lane Seabrook, NH 03874
 Map: 14 Lot: 25 Seq: 2

Please provide a sketch of the service connection with the approximate length. Please indicate the name of the street and a sketch of the house. In addition please show the approximate distances from any water lines on the property:

See Attached Drawings

Connection to Building

The applicant shall provide proper plumbing of building(s), which shall be in compliance with the International Plumbing Code as well as the rules and ordinances of the Town of Seabrook and the State of New Hampshire. The Town of Seabrook shall inspect and certify the plumbing, including the underground piping (before backfilling), prior to connection to the Town of Seabrook's sewer system.

--OFFICE USE ONLY--

GRANTED _____ DENIED _____ DATE _____

Board of Sewer Commissioners


REASON FOR DENIAL: _____ (CHAIRMAN) _____

Cat. Strydom 5/13/2020
 Sewer Superintendent 0 Date

AMOUNT PAID _____ CASH / CHECK # _____ DATE RECEIVED _____ BY _____

PLOT PLAN

Show setback distances from new structures to all property lines. Please remember that the front setback is measured from the property line, not from the road. Failure to submit a completed plot plan will delay the processing of your application. Plan must be in ink and legible

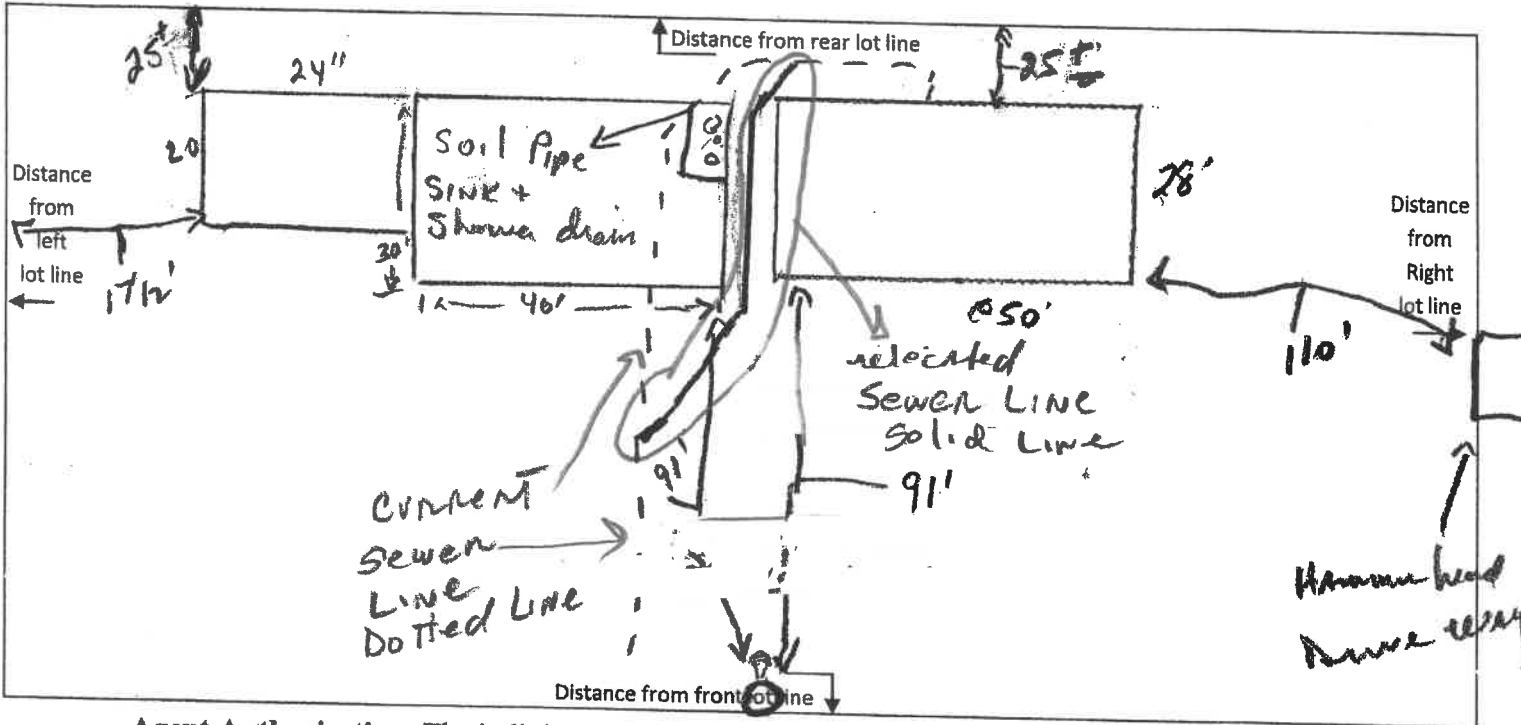

Agent Authorization: The individual listed as agent has my permission to act on my behalf for purposes of this application.

➤ **Property Owner Signature:** Charles Monell **Date:** _____

— OFFICE USE ONLY —
TO BE FILLED OUT BY BUILDING INSPECTOR

Water Permit: _____ Sewer Permit: _____ Demo Permit: _____ Driveway Permit: _____

Planning Board Case #: _____ ZBA Case #: _____

Date of Approval: _____

Date of Denial: _____ Reason for Denial: _____


If applicant was denied, indicate if the applicant was referred to: (circle)

Board of Adjustment Health Officer Board of Selectmen Planning Board

Building Inspector's Signature: _____

10-16-97	TOWN CREW WARNE - ROBERT		
	BROUGHT PIPE TO BACK OF HOUSE		
	AT MINIMUM PITCH		
	SEWER PIPE TUNNELED UNDER CONCRETE		
	PATIO JUST OFF EDGE OF PAVEMENT		
	INSULATION USED ON ALL SECTIONS OF		
	PIPE < 4' DEEP.		
	DRAWELL CONNECTION PASSED AND TIED IN		
	AWAITING PLUMBER FOR FINAL BACKSIDE		
	CONNECTION		

Building Dept
Jacoby

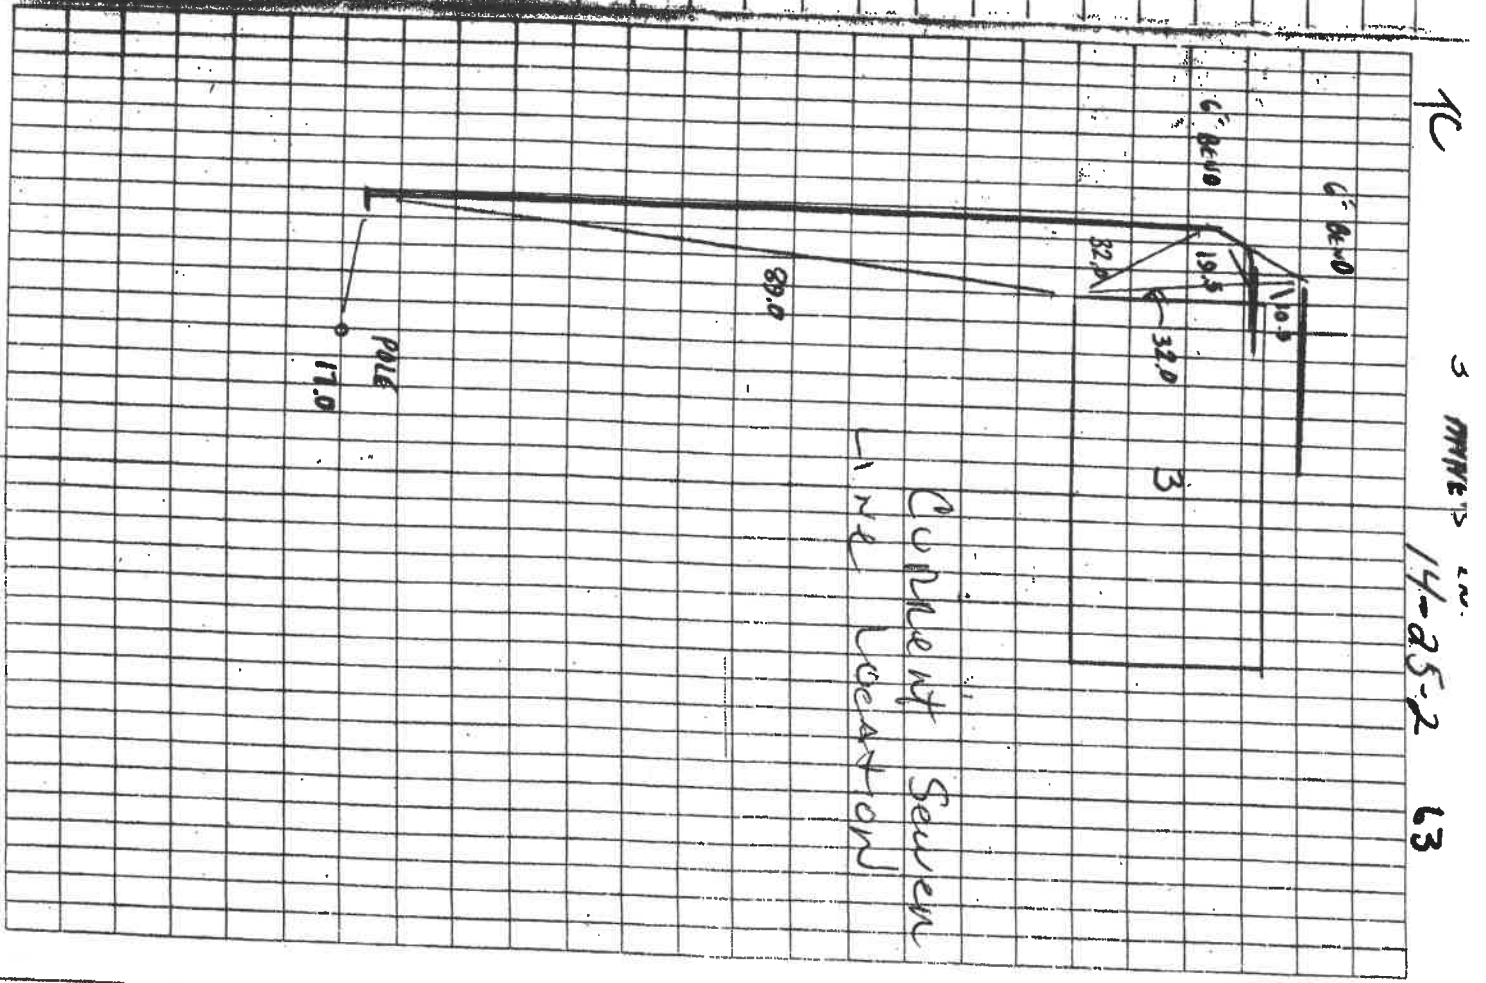

RC 5 THREE 20 14-25-2 63

10-16-97

TOWN CREW WORK - ROBERT

BRACKET PIPE TO BACK OF HOUSE
AT MINIMUM DEPTH

SEWER PIPE TUNNELED UNDER CONCRETE

PATIO JUST OFF EDGE OF MEMENTO

INSULATION USED ON ALL SECTIONS OF

PIPE < 4' DEEP.

DRIVEWELL CONNECTION PASSED AND TIED IN

AWAITING PLUMBER FOR FINAL BACKSIDE

CONNECTION


Building Dept
Jacoby

RC

3 DWG'S 20

14-25-2

63

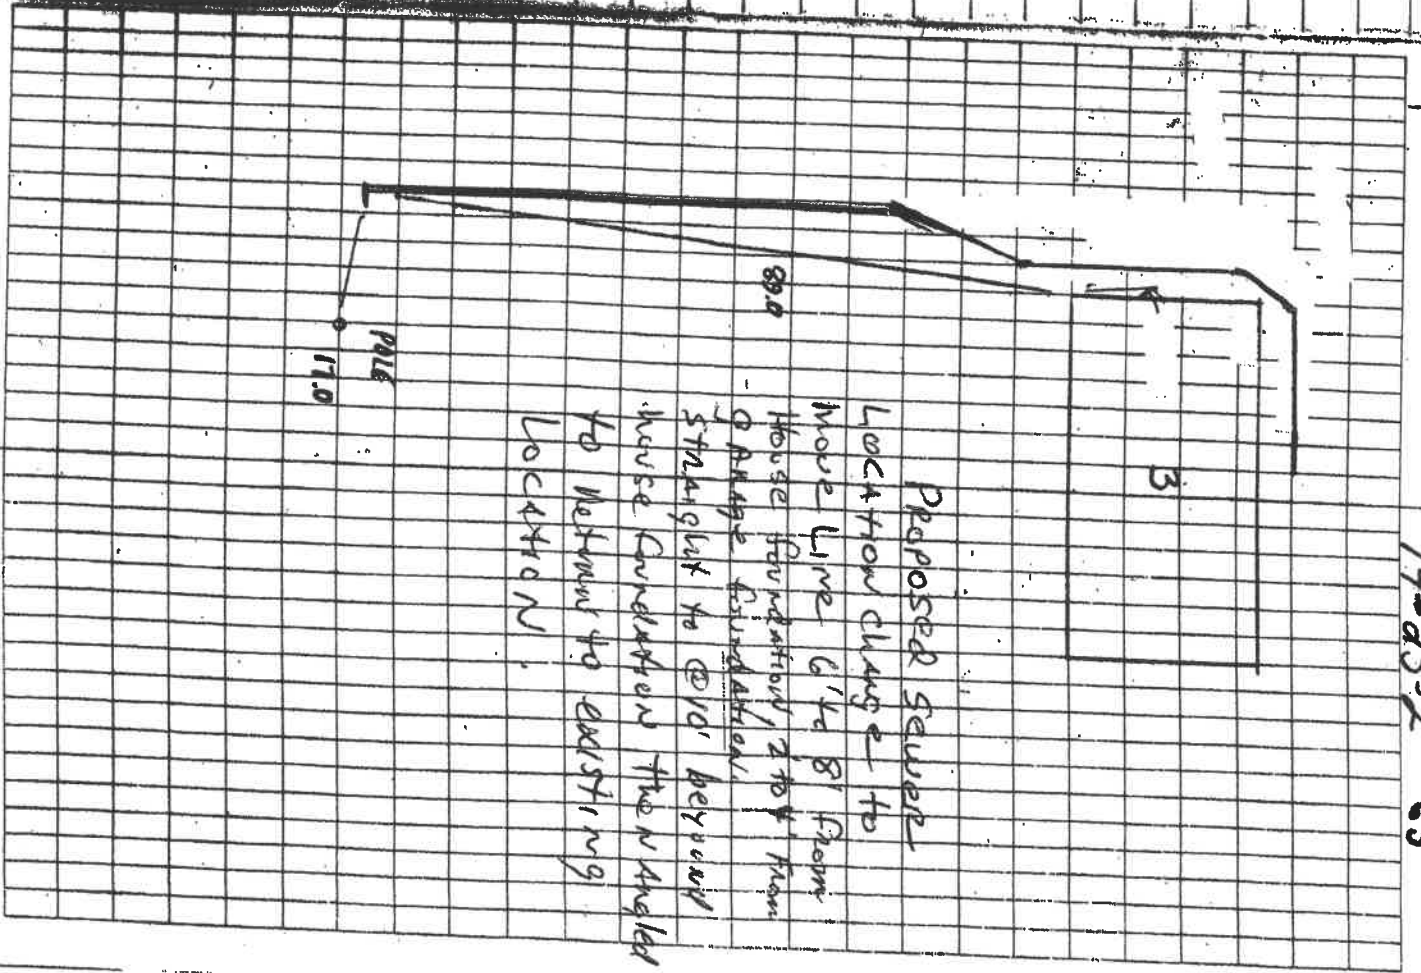

Proposed Sewer
 Location change to
 move line 6' to 8' from
 house foundation 2 to 4' from
 straight to @ 10' beyond
 house foundation then angled
 to nearest to existing
 location.

MAP 14 LOT 24

RAYMOND M. & RAYMOND L. CHANDLER

PARCEL N.T.S. PORTION OF MAP 14 LOT 25.3

N/E STRIPE BLVD CROSSING

MAP 14 LOT 25.3

MAP 14 LOT 32
GROESBE STRIPES
BILE HOME PARK
N 08.59.48 E
245.05

143.00
510.52.19 S
125.81
249.00
510.18.25 W
248.87

244.07
5 105.18.28 W

200' R.O.W.
N 10-18-

RUN E 5
N 10° 52' 19" W
158.00

PARCEL 8
29,426 @ 0.61 ACRES
MAP 14 LOT 2

N/E MORRILL

LOT AREA SEE ALIVE
VARIANCE

Address Building PL across W/ ALIEN STREETS
297.16

511-48-55 W
PART OF MAP 14 LOT 25
511-48-55 W

MAP 14 LOT 34




N/E Gerald G. & Helen Rowe

EARBROOK SCHOOL
DISTRICT

MAP 14 LOT 27

PARCEL 14
15,000 @ 0.344 ACRES
MAP 14 LOT 25-4
N/E MORRILL

100' ZOOING BOX

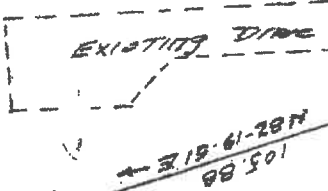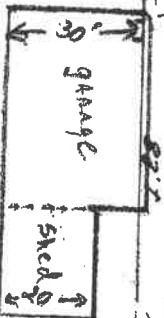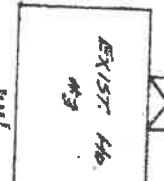

100' ZOOING BOX

154.93
5 84.03.05 E

N/E C
MAP

