



TOWN OF SEABROOK PUBLIC WATER SYSTEM

550 Route 107 ~ PO Box 456, Seabrook, NH 03874
Phone: (603) 474-9921 Fax: (603) 474-3399

WATER SERVICE APPLICATION

APPLICANT INFO SAME AS LANDOWNER? YES NO

DATE: 7-13-20

APPLICANT NAME/CORPORATION <u>Spednik LLC</u>			LANDOWNER/BILLING NAME <u>Same</u>		
APPLICANT ADDRESS <u>48 Blacksnake Rd</u>		HOME PHONE	BILLING ADDRESS		HOME PHONE
CITY <u>Seabrook N.H.</u>	ZIP CODE <u>03874</u>	WORK/OTHER PHONE <u>603-545-2602</u>	CITY	ZIP CODE	WORK/OTHER PHONE
E-MAIL ADDRESS OF APPLICANT			E-MAIL ADDRESS OF LANDOWNER		

SERVICE ADDRESS: 7 Adder Ln ASSESSOR'S MAP-LOT-SEQ 3-4-7

TYPE OF CONSTRUCTION: (Check All That Apply) NEW CONSTRUCTION RESIDENTIAL MULTI-FAMILY CONDO
 MOBILE/MANUFACTURED HOME COMMERCIAL INDUSTRIAL OTHER (Please Describe replacing structure)

*UNDER 'ADDITIONAL COMMENTS' SECTION, LIST NO. OF BUILDINGS AND NO. OF UNITS IN EACH BUILDING, IF APPLICABLE

NO. OF STORIES IN BUILDING: 1 BUILDING SIZE IN SQUARE FEET: 1568 TOTAL PARCEL AREA IN SQUARE FEET: 975 x 100

FIRE DEPARTMENT REQUIREMENTS NONE SPRINKLE ALL SPRINKLE GARAGE ONLY

FIRE HYDRANTS REQUIRED NONE PUBLIC (NO. OF HYDRANTS) PRIVATE (NO. OF HYDRANTS)

IS THERE A WELL ON THE PROPERTY? YES NO USING RECYCLED WATER? YES NO

WILL A PUMP BE USED TO BOOST PRESSURE? YES - FIRE SERVICE YES - DOMESTIC SERVICE NO

WILL THERE BE LANDSCAPE IRRIGATION? YES NO IF YES, NUMBER OF SPRINKLER HEADS:

FLOW OF EACH SPRINKLER HEAD IN GPM: TOTAL IRRIGATED AREA IN SQUARE FEET:

IF NON-RESIDENTIAL, DESCRIBE BUSINESS TYPE OR USAGE OF LOT:

SERVICES - LIST ALL REQUIRED PER PARCEL

POTABLE OR RECYCLED	SERVICE USE (RESIDENTIAL, FIRE, IRRIGATION, ETC.)	LATERAL SIZE	METER SIZE	MAX DEMAND IN GPM	ANTICIPATED DATE OF METER INSTALLATION
<u>POTABLE</u>	<u>RESIDENTIAL</u>		<u>IPERL 5/2</u>		<u>JULY/AUG.</u>

FIXTURE UNIT COUNT - COMPLETE THE QUANTITY OF THE FOLLOWING

BATHROOM:		KITCHEN:		LAUNDRY ROOM:		MISC/OTHER:	
TUBS/SHOWERS <u>1</u>	JACUZZI TUBS <u> </u>	DISHWASHERS <u>1</u>	CLOTHES WASHERS <u>1</u>	HOSEBIBS <u> </u>			
TUBS ONLY <u> </u>	TOILETS <u>2</u>	SINKS <u>1</u>	SINKS <u> </u>	BAR SINKS <u> </u>			
SHOWERS ONLY <u>1</u>	URINALS <u> </u>			POOL (SIZE: <u> </u>)			
SINKS <u>3</u>	BIDETS <u> </u>			DESCRIBE: <u> </u>			

ADDITIONAL COMMENTS (IF APPLICABLE, LIST NO. OF BUILDINGS AND NO. IN EACH BUILDING)

EXISTING LINE

LAND OWNER'S SIGNATURE Steven Lago DATE 7-13-20

By signing above, I agree I will not hold the Seabrook Water Department responsible for any damages to my property, which may be incurred during, or as a result of the water installation.

**ALSO: THIS APPLICATION WILL EXPIRE 2 YEARS AFTER APPROVAL BY THE BOARD OF SELECTMEN and THE FEE WILL BE NONREFUNDABLE

CORPORATION NAME Spednik LLC OFFICER'S NAME & TITLE (PRINT) Steven Lago Member

APPLICANT/CORPORATION'S OFFICER SIGNATURE Steven Lago DATE 7-13-20




TOWN OF SEABROOK PUBLIC WATER SYSTEM
 550 Route 107 - PO Box 456, Seabrook, NH 03874
 Phone: (603) 474-9921 Fax: (603) 474-3399
WATER SERVICE APPLICATION

Service Connection Ties

Address: 7 ADDER LN

Please provide a sketch of the service connection with the approximate length. Please indicate the name of the street and a sketch of the house. In addition, please show the approximate distances from any sewer lines on the property.

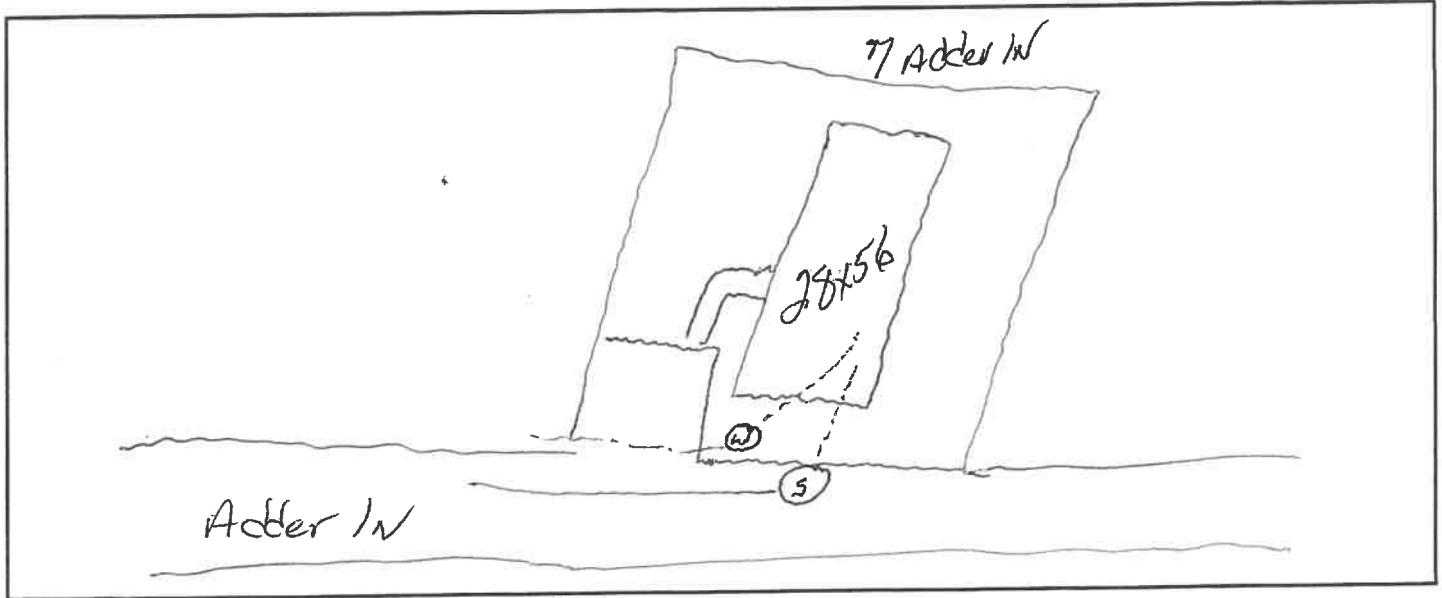

Connection to Building
 The applicant shall provide proper plumbing of building(s), which shall be in compliance with the International Plumbing Code as well as the Rules and Ordinances of the Town of Seabrook and the State of New Hampshire. Water lines are required to be inspected by the Water Department before backfilling.

-OFFICE USE ONLY-

GRANTED ___ DENIED ___ DATE _____ Board of Water Commissioners

REASON FOR DENIAL: _____ (Chairman)

Curt Stryker 7/13/202
 Water Superintendent 0 Date

AMOUNT PAID: 50.00 CASH/CHECK # 6643 7-13-20 BY S.G.