



# TOWN OF SEABROOK PUBLIC WATER SYSTEM

550 Route 107 ~ PO Box 456, Seabrook, NH 03874

Phone: (603) 474-9921 Fax: (603) 474-3399

## WATER SERVICE APPLICATION

APPLICANT INFO SAME AS LANDOWNER?  YES  NO

DATE: 9.2.2020

APPLICANT NAME/CORPORATION <u>Jabe Felch</u>		LANDOWNER/BILLING NAME <u>Same as applicant</u>	
APPLICANT ADDRESS <u>23A Worthley Ave</u>		BILLING ADDRESS	
CITY <u>Seabrook</u>	HOME PHONE <u>603 944 1868</u>	CITY	HOME PHONE
ZIP CODE <u>03874</u>	WORK/OTHER PHONE	ZIP CODE	WORK/OTHER PHONE
E-MAIL ADDRESS OF APPLICANT <u>fwf62686@aol.com</u>		E-MAIL ADDRESS OF LANDOWNER	

SERVICE ADDRESS: 23 A WORTHLEY AVE ASSESSOR'S MAP-LOT-SEQ: 16-70-1

TYPE OF CONSTRUCTION: (Check All That Apply)  NEW CONSTRUCTION  RESIDENTIAL  SINGLE FAMILY  MULTI-FAMILY  CONDO

MOBILE/MANUFACTURED HOME  COMMERCIAL  INDUSTRIAL  OTHER (Please Describe) \_\_\_\_\_

\*UNDER 'ADDITIONAL COMMENTS' SECTION, LIST NO. OF BUILDINGS AND NO. OF UNITS IN EACH BUILDING, IF APPLICABLE

NO. OF STORIES IN BUILDING: 2 BUILDING SIZE IN SQUARE FEET: 2781 TOTAL PARCEL AREA IN SQUARE FEET: \_\_\_\_\_

FIRE DEPARTMENT REQUIREMENTS  NONE  SPRINKLE ALL  SPRINKLE GARAGE ONLY

FIRE HYDRANTS REQUIRED  NONE  PUBLIC (NO. OF HYDRANTS \_\_\_\_\_) PRIVATE (NO. OF HYDRANTS \_\_\_\_\_)

IS THERE A WELL ON THE PROPERTY? YES  NO  USING RECYCLED WATER? YES  NO

WILL A PUMP BE USED TO BOOST PRESSURE? YES - FIRE SERVICE  YES - DOMESTIC SERVICE  NO

WILL THERE BE LANDSCAPE IRRIGATION? YES  NO  IF YES, NUMBER OF SPRINKLER HEADS: \_\_\_\_\_

FLOW OF EACH SPRINKLER HEAD IN GPM: \_\_\_\_\_ TOTAL IRRIGATED AREA IN SQUARE FEET: \_\_\_\_\_

IF NON-RESIDENTIAL, DESCRIBE BUSINESS TYPE OR USAGE OF LOT: \_\_\_\_\_

SERVICES - LIST ALL REQUIRED PER PARCEL					
POTABLE OR RECYCLED	SERVICE USE (RESIDENTIAL, FIRE, IRRIGATION, ETC.)	LATERAL SIZE	METER SIZE	MAX DEMAND IN GPM	ANTICIPATED DATE OF METER INSTALLATION
<u>potable</u>	<u>residential</u>	<u>-</u>	<u>5/8"</u>	<u>-</u>	<u>-</u>

FIXTURE UNIT COUNT - COMPLETE THE QUANTITY OF THE FOLLOWING

BATHROOM:		KITCHEN:		LAUNDRY ROOM:		MISC/OTHER:	
TUBS/SHOWERS	<u>1</u>	JACUZZI TUBS	<u>1</u>	DISHWASHERS	<u>1</u>	CLOTHES WASHERS	<u>1</u>
TUBS ONLY		TOILETS	<u>3</u>	SINKS	<u>1</u>	SINKS	
SHOWERS ONLY	<u>1</u>	URINALS					
SINKS	<u>5</u>	BIDETS					

POOL (SIZE: \_\_\_\_\_) DESCRIBE: \_\_\_\_\_

ADDITIONAL COMMENTS (IF APPLICABLE, LIST NO. OF BUILDINGS AND NO. IN EACH BUILDING) \_\_\_\_\_

LAND OWNER'S SIGNATURE Jabe Fu DATE 9.2.2020

By signing above, I agree I will not hold the Seabrook Water Department responsible for any damages to my property, which may be incurred during, or as a result of the water installation.  
\*\*ALSO: THIS APPLICATION WILL EXPIRE 2 YEARS AFTER APPROVAL BY THE BOARD OF SELECTMEN and THE FEE WILL BE NONREFUNDABLE

CORPORATION NAME \_\_\_\_\_ OFFICER'S NAME & TITLE (PRINT) \_\_\_\_\_  
APPLICANT/CORPORATION'S OFFICER SIGNATURE Jabe Felch DATE 9.2.2020



**TOWN OF SEABROOK PUBLIC WATER SYSTEM**

550 Route 107 ~ PO Box 456, Seabrook, NH 03874


Phone: (603) 474-9921 Fax: (603) 474-3399

**WATER SERVICE APPLICATION**

**Service Connection Ties**

Address: 23A Worthley Ave

Please provide a sketch of the service connection with the approximate length. Please indicate the name of the street and a sketch of the house. In addition, please show the approximate distances from any sewer lines on the property.

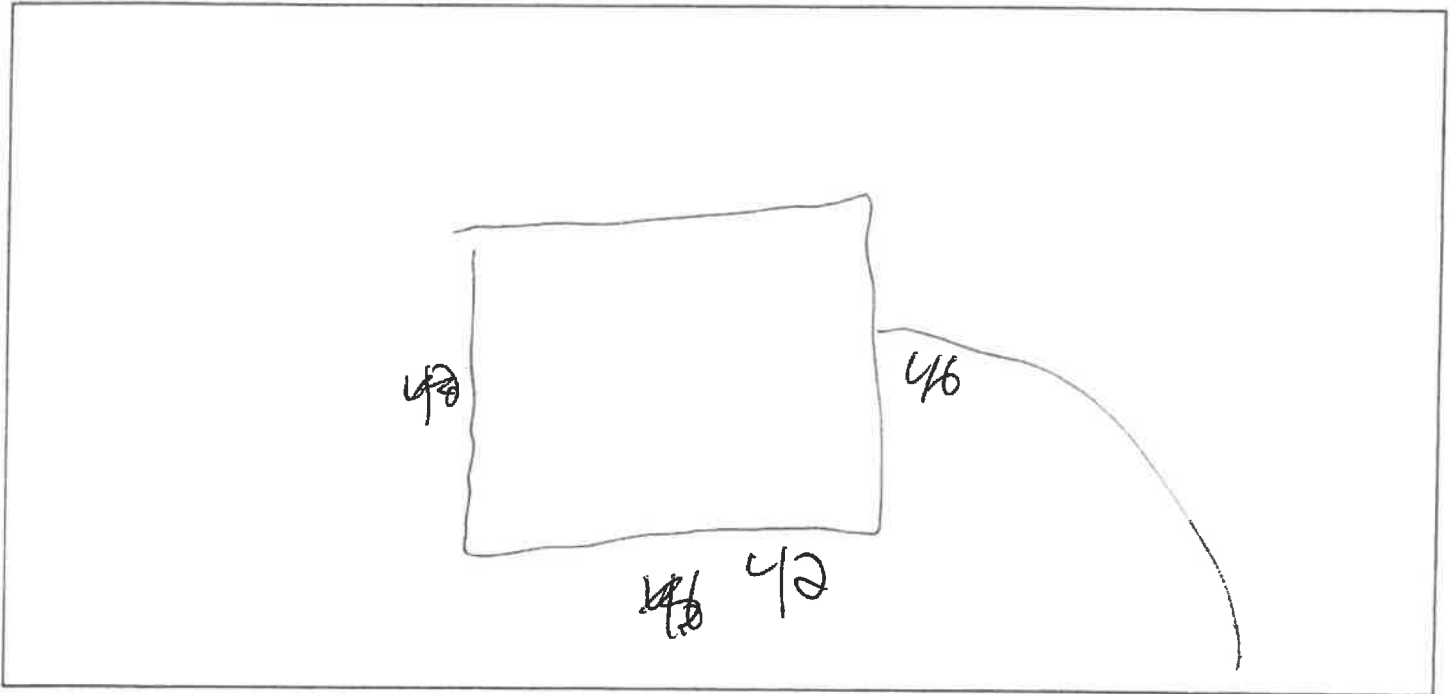

**Connection to Building**

The applicant shall provide proper plumbing of building(s), which shall be in compliance with the International Plumbing Code as well as the Rules and Ordinances of the Town of Seabrook and the State of New Hampshire. Water lines are required to be inspected by the Water Department before backfilling.

**-OFFICE USE ONLY-**

GRANTED \_\_\_ DENIED \_\_\_ DATE \_\_\_\_\_

Board of Water Commissioners

REASON FOR DENIAL: \_\_\_\_\_

(Chairman)

*Curt Skyles*

9/4/202

Water Superintendent

0

Date

AMOUNT PAID: 1,300<sup>00</sup>

CASH/CHECK # 308

DATE RECEIVED 9/3/20

BY *AW*