



TOWN OF SEABROOK PUBLIC WATER SYSTEM

550 Route 107 ~ PO Box 456, Seabrook, NH 03874

Phone: (603) 474-9921 Fax: (603) 474-3399

WATER SERVICE APPLICATION

APPLICANT INFO SAME AS LANDOWNER? YES NO

DATE: 12/18/20

APPLICANT NAME/CORPORATION: Ronald D Bary
LANDOWNER/BILLING NAME: Ronald D Bary
APPLICANT ADDRESS: PO Box 2149
BILLING ADDRESS: PO Box 2149
CITY/STATE: Seabrook NH
ZIP CODE: 03874
E-MAIL ADDRESS OF APPLICANT: rdbery@msn.com

SERVICE ADDRESS: 176 TILTON STREET
ASSESSOR'S MAP-LOT-SEQ: 20-176
TYPE OF CONSTRUCTION: RESIDENTIAL SINGLE FAMILY
water line replacement

NO. OF STORIES IN BUILDING: 1
BUILDING SIZE IN SQUARE FEET: 2,000
TOTAL PARCEL AREA IN SQUARE FEET: .11 acre
FIRE DEPARTMENT REQUIREMENTS: NONE
IS THERE A WELL ON THE PROPERTY? NO
WILL A PUMP BE USED TO BOOST PRESSURE? YES - FIRE SERVICE
WILL THERE BE LANDSCAPE IRRIGATION? NO

Table with 6 columns: POTABLE OR RECYCLED, SERVICE USE, LATERAL SIZE, METER SIZE, MAX DEMAND IN GPM, ANTICIPATED DATE OF METER INSTALLATION. Row 1: potable, residential, -, 5/8", -, -

FIXTURE UNIT COUNT - COMPLETE THE QUANTITY OF THE FOLLOWING
BATHROOM: TUBS/SHOWERS 1, TOILETS 2, SINKS 2
KITCHEN: DISHWASHERS 1, SINKS 1
LAUNDRY ROOM: CLOTHES WASHERS 1, SINKS 1
MISC/OTHER: HOSEBIBS, BAR SINKS, POOL (SIZE:), DESCRIBE:

LAND OWNER'S SIGNATURE: Ronald D Bary
DATE: 12/18/20

By signing above, I agree I will not hold the Seabrook Water Department responsible for any damages to my property, which may be incurred during, or as a result of the water installation.

**ALSO: THIS APPLICATION WILL EXPIRE 2 YEARS AFTER APPROVAL BY THE BOARD OF SELECTMEN and THE FEE WILL BE NONREFUNDABLE

CORPORATION NAME: Ronald D Bary
OFFICER'S NAME & TITLE (PRINT):

APPLICANT/CORPORATION'S OFFICER SIGNATURE
DATE: 12/18/20



TOWN OF SEABROOK PUBLIC WATER SYSTEM


550 Route 107 ~ PO Box 456, Seabrook, NH 03874
Phone: (603) 474-9921 Fax: (603) 474-3399

WATER SERVICE APPLICATION

Service Connection Ties

Address: 176 Tilton St

Please provide a sketch of the service connection with the approximate length. Please indicate the name of the street and a sketch of the house. In addition, please show the approximate distances from any sewer lines on the property.

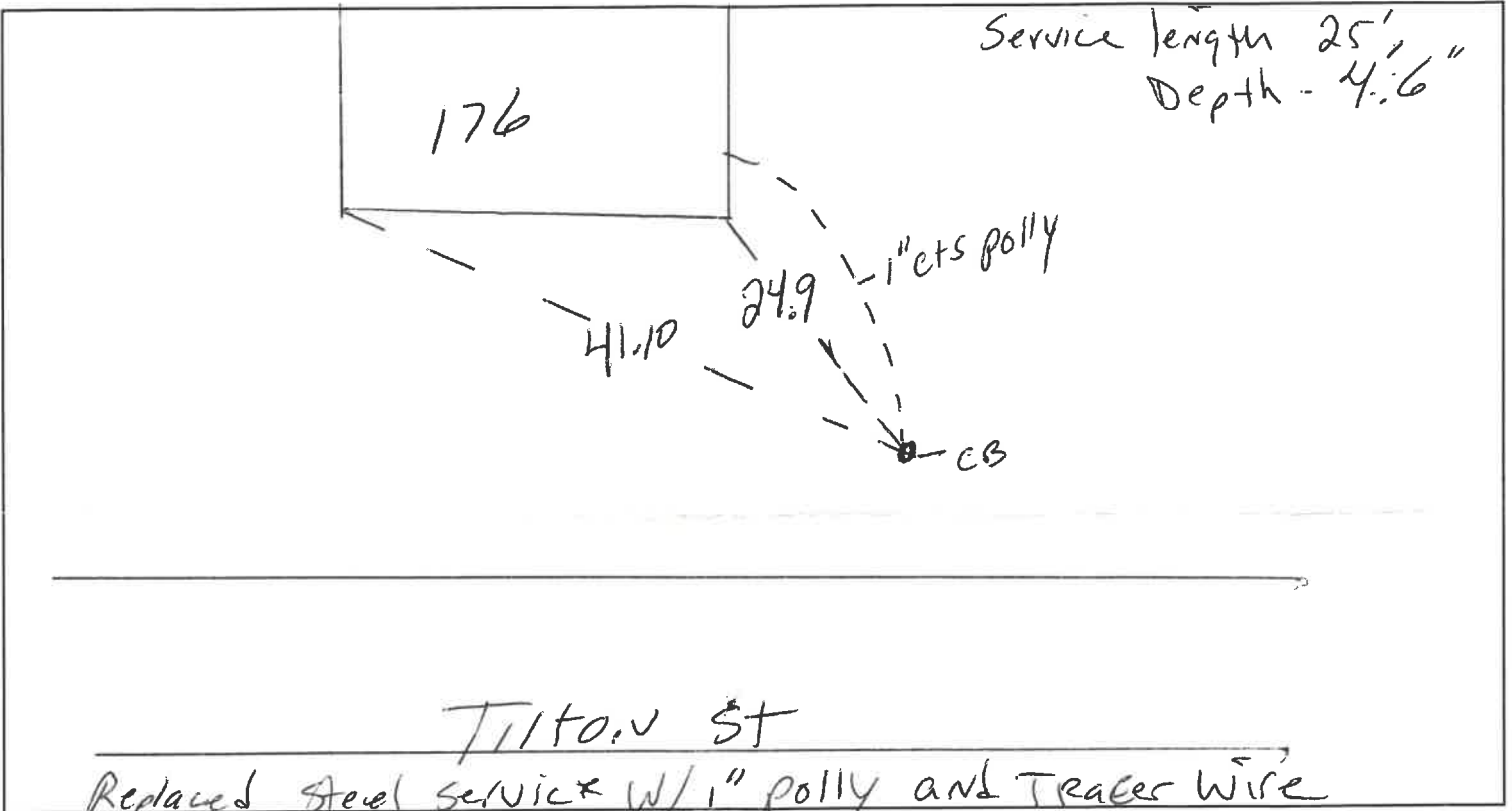

Connection to Building

The applicant shall provide proper plumbing of building(s), which shall be in compliance with the International Plumbing Code as well as the Rules and Ordinances of the Town of Seabrook and the State of New Hampshire. Water lines are required to be inspected by the Water Department before backfilling.

-OFFICE USE ONLY-

GRANTED ___ DENIED ___ DATE _____

REASON FOR DENIAL: _____

Board of Water Commissioners

(Chairman)

Water Superintendent

Date

AMOUNT PAID: 100 CASH/CHECK # 7752 DATE RECEIVED 12/22/20 BY [Signature]