



TOWN OF SEABROOK PUBLIC WATER SYSTEM

550 Route 107 - PO Box 456, Seabrook, NH 03874

Phone: (603) 474-9921 Fax: (603) 474-3399

WATER SERVICE APPLICATION

APPLICANT INFO SAME AS LANDOWNER? YES NO

DATE: 6/9/23

APPLICANT NAME/CORPORATION: Michael Tehen
APPLICANT ADDRESS: 26 Skjop rd, Ipswich MA, ZIP CODE: 01938
HOME PHONE: 978-836-6969
WORK/OTHER PHONE:
E-MAIL ADDRESS OF APPLICANT: Tehen.construction@gmail.com

LANDOWNER/BILLING NAME: Same
BILLING ADDRESS:
HOME PHONE:
CITY:
ZIP CODE:
WORK/OTHER PHONE:
E-MAIL ADDRESS OF LANDOWNER:

SERVICE ADDRESS: 30 Mill Lane Unit 2
ASSESSOR'S MAP-LOT-SEQ:
TYPE OF CONSTRUCTION: NEW CONSTRUCTION
RESIDENTIAL SINGLE FAMILY MULTI-FAMILY CONDO
MOBILE/MANUFACTURED HOME COMMERCIAL INDUSTRIAL OTHER (Please Describe): Duplex new line
*UNDER 'ADDITIONAL COMMENTS' SECTION, LIST NO. OF BUILDINGS AND NO. OF UNITS IN EACH BUILDING, IF APPLICABLE

NO. OF STORIES IN BUILDING: 2 BUILDING SIZE IN SQUARE FEET: 2000 TOTAL PARCEL AREA IN SQUARE FEET:
FIRE DEPARTMENT REQUIREMENTS: NONE SPRINKLE ALL SPRINKLE GARAGE ONLY
FIRE HYDRANTS REQUIRED: NONE PUBLIC (NO. OF HYDRANTS) PRIVATE (NO. OF HYDRANTS)
IS THERE A WELL ON THE PROPERTY? YES NO USING RECYCLED WATER? YES NO
WILL A PUMP BE USED TO BOOST PRESSURE? YES - FIRE SERVICE YES - DOMESTIC SERVICE NO
WILL THERE BE LANDSCAPE IRRIGATION? YES IF YES, NUMBER OF SPRINKLER HEADS:
FLOW OF EACH SPRINKLER HEAD IN GPM: TOTAL IRRIGATED AREA IN SQUARE FEET:
IF NON-RESIDENTIAL, DESCRIBE BUSINESS TYPE OR USAGE OF LOT:

SERVICES - LIST ALL REQUIRED PER PARCEL

Table with 6 columns: POTABLE OR RECYCLED, SERVICE USE (RESIDENTIAL, FIRE, IRRIGATION, ETC.), LATERAL SIZE, METER SIZE, MAX DEMAND IN GPM, ANTICIPATED DATE OF METER INSTALLATION

FIXTURE UNIT COUNT - COMPLETE THE QUANTITY OF THE FOLLOWING

BATHROOM: TUBS/SHOWERS 3, JACUZZI TUBS, TUBS ONLY, TOILETS 4, SHOWERS ONLY 5, URINALS, SINKS, BIDETS
KITCHEN: DISHWASHERS 1, SINKS
LAUNDRY ROOM: CLOTHES WASHERS 1, SINKS
MISC/OTHER: HOSEBIBS, BAR SINKS, POOL (SIZE), DESCRIBE:

ADDITIONAL COMMENTS (IF APPLICABLE, LIST NO. OF BUILDINGS AND NO. IN EACH BUILDING)

LAND OWNER'S SIGNATURE

DATE 6/9/23

By signing above, I agree I will not hold the Seabrook Water Department responsible for any damages to my property, which may be incurred during, or as a result of the water installation.

**ALSO: THIS APPLICATION WILL EXPIRE 2 YEARS AFTER APPROVAL BY THE BOARD OF SELECTMEN and THE FEE WILL BE NONREFUNDABLE

CORPORATION NAME Tehen construction LLC

OFFICER'S NAME & TITLE (PRINT) President

APPLICANT/CORPORATION'S OFFICER SIGNATURE

DATE 6/9/23




TOWN OF SEABROOK PUBLIC WATER SYSTEM
 550 Route 107 - PO Box 456, Seabrook, NH 03874
 Phone: (603) 474-9921 Fax: (603) 474-3399
WATER SERVICE APPLICATION

Service Connection Ties

Address: 30 Mill Ln #2

Please provide a sketch of the service connection with the approximate length. Please indicate the name of the street and a sketch of the house. In addition, please show the approximate distances from any sewer lines on the property.

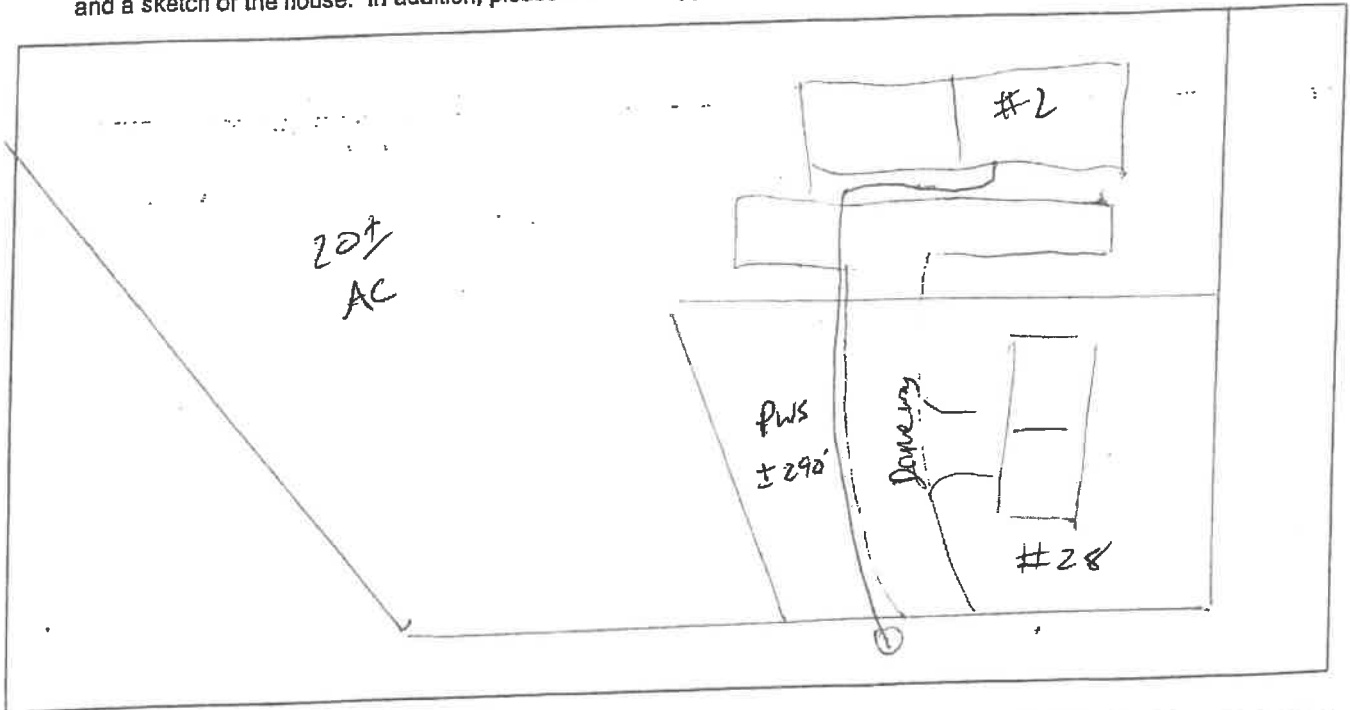

Connection to Building

The applicant shall provide proper plumbing of building(s), which shall be in compliance with the International Plumbing Code as well as the Rules and Ordinances of the Town of Seabrook and the State of New Hampshire. Water lines are required to be inspected by the Water Department before backfilling.

-OFFICE USE ONLY-

GRANTED ___ DENIED ___ DATE _____

Board of Water Commissioners

REASON FOR DENIAL: _____

(Chairman)

[Signature]
Water Superintendent

6/9/23

Date

AMOUNT PAID: \$1300

CASH/CHECK # 114

DATE RECEIVED 6-9-23

BY MS