



TOWN OF SEABROOK PUBLIC WATER SYSTEM

550 Route 107 ~ PO Box 456, Seabrook, NH 03874

Phone: (603) 474-9921 Fax: (603) 474-3399

WATER SERVICE APPLICATION

APPLICANT INFO SAME AS LANDOWNER? YES NO

DATE: 5/24/2023

APPLICANT NAME/CORPORATION <i>Fidac AZOURI</i>			LANDOWNER/BILLING NAME <i>Fidac AZOURI</i>		
APPLICANT ADDRESS <i>61 S MAIN STREET</i>		HOME/WORK PHONE	BILLING ADDRESS <i>61 S MAIN ST</i>		HOME/WORK PHONE
CITY/STATE <i>SEABROOK, NH</i>	ZIP CODE <i>03874</i>	WORK/OTHER PHONE <i>833-8578</i>	CITY/STATE <i>SEABROOK, NH</i>	ZIP CODE <i>03874</i>	WORK/OTHER PHONE <i>833-8578</i>
E-MAIL ADDRESS OF APPLICANT			E-MAIL ADDRESS OF LANDOWNER		

SERVICE ADDRESS: *61 A S MAIN ST, SEABROOK, NH* ASSESSOR'S MAP-LOT-SEQ: _____

TYPE OF CONSTRUCTION: (Check All That Apply) NEW CONSTRUCTION RESIDENTIAL SINGLE FAMILY MULTI-FAMILY CONDO

MOBILE/MANUFACTURED HOME COMMERCIAL INDUSTRIAL OTHER (Please Describe) _____

**UNDER 'ADDITIONAL COMMENTS' SECTION, LIST NO. OF BUILDINGS AND NO. OF UNITS IN EACH BUILDING, IF APPLICABLE*

NO. OF STORIES IN BUILDING: _____ BUILDING SIZE IN SQUARE FEET: _____ TOTAL PARCEL AREA IN SQUARE FEET: _____

FIRE DEPARTMENT REQUIREMENTS NONE SPRINKLE ALL SPRINKLE GARAGE ONLY

FIRE HYDRANTS REQUIRED NONE PUBLIC (NO. OF HYDRANTS _____) PRIVATE (NO. OF HYDRANTS _____)

IS THERE A WELL ON THE PROPERTY? YES NO USING RECYCLED WATER? YES NO

WILL A PUMP BE USED TO BOOST PRESSURE? YES - FIRE SERVICE YES - DOMESTIC SERVICE NO

WILL THERE BE LANDSCAPE IRRIGATION? YES NO IF YES, NUMBER OF SPRINKLER HEADS: _____

FLOW OF EACH SPRINKLER HEAD IN GPM: _____ TOTAL IRRIGATED AREA IN SQUARE FEET: _____

IF NON-RESIDENTIAL, DESCRIBE BUSINESS TYPE OR USAGE OF LOT: _____

SERVICES - LIST ALL REQUIRED PER PARCEL

POTABLE OR RECYCLED	SERVICE USE (RESIDENTIAL, FIRE, IRRIGATION, ETC.)	LATERAL SIZE	METER SIZE	MAX DEMAND IN GPM	ANTICIPATED DATE OF METER INSTALLATION
potable	residential	-	5/8"	-	-

FIXTURE UNIT COUNT - COMPLETE THE QUANTITY OF THE FOLLOWING

BATHROOM:		KITCHEN:		LAUNDRY ROOM:		MISC/OTHER:	
TUBS/SHOWERS	JACUZZI TUBS	DISHWASHERS	SINKS	CLOTHES WASHERS	SINKS	HOSEBIBS	
TUBS ONLY	TOILETS					BAR SINKS	
SHOWERS ONLY	URINALS					POOL (SIZE: _____)	
SINKS	BIDETS					DESCRIBE: _____	

LAND OWNER'S SIGNATURE *Fidac AZOURI* DATE 5/24/23

By signing above, I agree I will not hold the Seabrook Water Department responsible for any damages to my property, which may be incurred during, or as a result of the water installation.

****ALSO: THIS APPLICATION WILL EXPIRE 2 YEARS AFTER APPROVAL BY THE BOARD OF SELECTMEN and THE FEE WILL BE NONREFUNDABLE**

CORPORATION NAME _____ OFFICER'S NAME & TITLE (PRINT) _____

APPLICANT/CORPORATION'S OFFICER SIGNATURE *Fidac AZOURI* DATE 5/24/2023



TOWN OF SEABROOK PUBLIC WATER SYSTEM

550 Route 107 ~ PO Box 456, Seabrook, NH 03874

Phone: (603) 474-9921 Fax: (603) 474-3399


WATER SERVICE APPLICATION

Service Connection Ties

Address: 61 A South Main St

Please provide a sketch of the service connection with the approximate length. Please indicate the name of the street and a sketch of the house. In addition, please show the approximate distances from any sewer lines on the property.

I REPAIR THE 61 A. S. MAIN STREET SEABROOK NH, I HAVE THE TRAIL. OUR MOB HOME. 24" NEW PIPING TO BE REPAIRED THANK YOU'S.

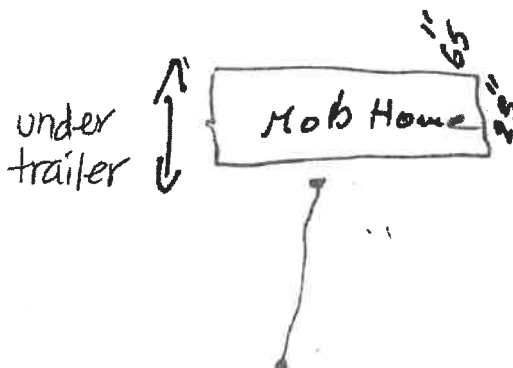

Connection to Building

The applicant shall provide proper plumbing of building(s), which shall be in compliance with the International Plumbing Code as well as the Rules and Ordinances of the Town of Seabrook and the State of New Hampshire. Water lines are required to be inspected by the Water Department before backfilling.

-OFFICE USE ONLY-

GRANTED ___ DENIED ___ DATE _____

Board of Water Commissioners

REASON FOR DENIAL: _____

(Chairman)

[Signature]
Water Superintendent

5/31/23

Date

AMOUNT PAID: \$50

CASH CHECK 384

DATE RECEIVED 5-24-23

BY MS