



TOWN OF SEABROOK PUBLIC WATER SYSTEM

550 Route 107 - PO Box 456, Seabrook, NH 03874

Phone: (603) 474-9921 Fax: (603) 474-3399

WATER SERVICE APPLICATION

APPLICANT INFO SAME AS LANDOWNER? YES NO

DATE: 8 29 23

APPLICANT NAME/CORPORATION <u>Cote & Foster Cont.</u>		LANDOWNER/BILLING NAME <u>Fran & Keenan</u>	
APPLICANT ADDRESS <u>20 Aegean Drive</u>		HOME/WORK PHONE <u>781 265 1818</u>	BILLING ADDRESS <u>557 Hudson St.</u>
CITY/STATE <u>Methuen Ma.</u>	ZIP CODE <u>01844</u>	WORK/OTHER PHONE <u>781 423 6429</u>	CITY/STATE <u>Seabrook</u>
E-MAIL ADDRESS OF APPLICANT <u>Star + cote + foster.com</u>		ZIP CODE <u>03874</u>	WORK/OTHER PHONE <u>617 765 9035</u>
		E-MAIL ADDRESS OF LANDOWNER <u>francy@nbc.com</u>	

SERVICE ADDRESS: 152 ATLANTIC AVE ASSESSOR'S MAP-LOT-SEQ: 21 15-16

TYPE OF CONSTRUCTION: (Check All That Apply) NEW CONSTRUCTION RESIDENTIAL SINGLE FAMILY MULTI-FAMILY CONDO

MOBILE/MANUFACTURED HOME COMMERCIAL INDUSTRIAL (Please Describe)

**UNDER 'ADDITIONAL COMMENTS' SECTION, LIST NO. OF BUILDINGS AND NO. OF UNITS IN EACH BUILDING, IF APPLICABLE*

NO. OF STORIES IN BUILDING: 3 BUILDING SIZE IN SQUARE FEET: 4637 TOTAL PARCEL AREA IN SQUARE FEET: 19,000

FIRE DEPARTMENT REQUIREMENTS: NONE SPRINKLE ALL SPRINKLE GARAGE ONLY

FIRE HYDRANTS REQUIRED: NONE PUBLIC (NO. OF HYDRANTS:) PRIVATE (NO. OF HYDRANTS:)

IS THERE A WELL ON THE PROPERTY? YES NO USING RECYCLED WATER? YES NO

WILL A PUMP BE USED TO BOOST PRESSURE? YES - FIRE SERVICE YES - DOMESTIC SERVICE NO

WILL THERE BE LANDSCAPE IRRIGATION? YES NO IF YES, NUMBER OF SPRINKLER HEADS:

FLOW OF EACH SPRINKLER HEAD IN GPM: TOTAL IRRIGATED AREA IN SQUARE FEET:


IF NON-RESIDENTIAL, DESCRIBE BUSINESS TYPE OR USAGE OF LOT:

SERVICES - LIST ALL REQUIRED PER PARCEL

POTABLE OR RECYCLED	SERVICE USE (RESIDENTIAL, FIRE, IRRIGATION, ETC.)	LATERAL SIZE	METER SIZE	MAX DEMAND IN GPM	ANTICIPATED DATE OF METER INSTALLATION
potable	residential	-	5/8"	-	-

FIXTURE UNIT COUNT - COMPLETE THE QUANTITY OF THE FOLLOWING

BATHROOM:		KITCHEN:		LAUNDRY ROOM:		MISCELLANEOUS:	
TUBS/SHOWERS	JACUZZI TUBS	DISHWASHERS	SINKS	CLOTHES WASHERS	SINKS	HOSE/BIBS	BAR SINKS
<u>1</u>	<u>0</u>	<u>1</u>	<u>1</u>	<u>2</u>	<u>7</u>	<u>3</u>	<u>7</u>
TUBS ONLY	TOILETS					POOL (SIZE: <u> </u>)	DESCRIBE: <u> </u>
<u>0</u>	<u>5</u>						
TUBS ONLY	URINALS						
<u>2</u>	<u>0</u>						
<u>8</u>	BIDETS						
	<u>0</u>						

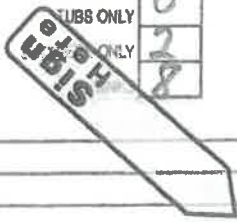

Replacing existing line

Dudith Chennel

LAND OWNER'S SIGNATURE

DATE

By signing above, I agree I will not hold the Seabrook Water Department responsible for any damages to my property, which may be incurred during, or as a result of the water installation.

****ALSO: THIS APPLICATION WILL EXPIRE 2 YEARS AFTER APPROVAL BY THE BOARD OF SELECTMEN and THE FEE WILL BE NONREFUNDABLE**

CORPORATION NAME Cote & Foster Cont. OFFICER'S NAME & TITLE (PRINT) Star Cote U.P.

APPLICANT/CORPORATION'S OFFICER SIGNATURE

DATE

8/29/23

ACCOUNT #

058650

COPY



TOWN OF SEABROOK PUBLIC WATER SYSTEM

550 Route 107 - PO Box 456, Seabrook, NH 03874


Phone: (603) 474-9921 Fax: (603) 474-3399

WATER SERVICE APPLICATION

Service Connection Ties

Address: 152 Atlantic Ave

Please provide a sketch of the service connection with the approximate length. Please indicate the name of the street and a sketch of the house. In addition, please show the approximate distances from any sewer lines on the property.

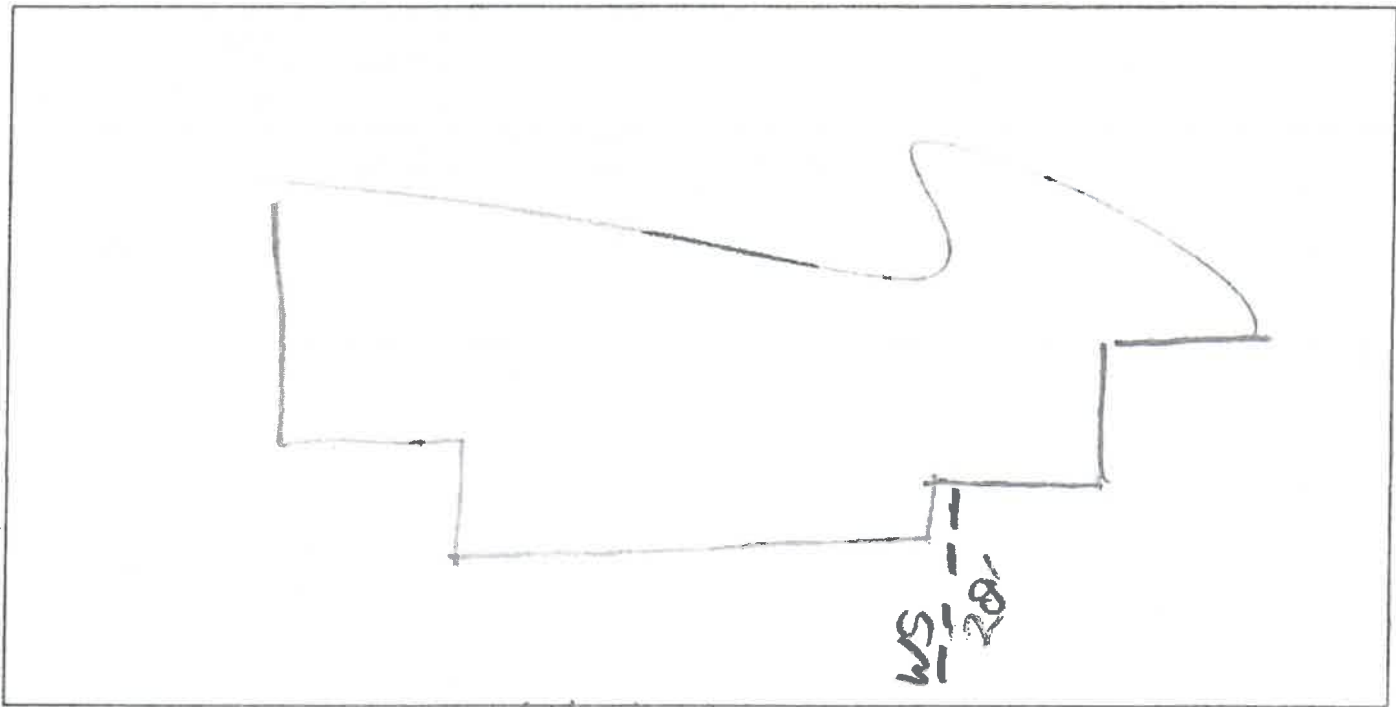

Connection to Building

The applicant shall provide proper plumbing of building(s), which shall be in compliance with the International Plumbing Code as well as the Rules and Ordinances of the Town of Seabrook and the State of New Hampshire. Water lines are required to be inspected by the Water Department before backfilling.

-OFFICE USE ONLY-

GRANTED ___ DENIED ___ DATE _____

Board of Water Commissioners

REASON FOR DENIAL: _____

(Chairman)

C. J. A. 9/6/23
Water Superintendent

Date

AMOUNT PAID: \$100

CASH REC'D: 1517

DATE RECEIVED: 8-30-23

BY: ms