

TOWN OF SEABROOK
SEWER DEPARTMENT &
WASTEWATER TREATMENT FACILITY
 PO BOX 456 • WRIGHT'S ISLAND • SEABROOK, NH 03874
 PHONE (603) 474-8012 • FAX (603) 474-8014



APPLICATION FOR SEWER SERVICE

DATE: 2/7/24

APPLICANT / BUSINESS NAME North Coast Curb LLC
 SERVICE ADDRESS 85 Hedge road
 MAP 5 LOT 8 SEQ. 703 ZONING DISTRICT _____ IS LOT IN CURRENT USE? Y / N
 MAILING ADDRESS 62 Folly Mill rd. CITY Salisbury STATE MA ZIP 01952
 PHONE _____ CELL 978 375 3943 EMAIL ben@northcoastcurb.com
 PROPERTY OWNER (IF DIFFERENT THAN ABOVE) _____ PHONE _____

TYPE OF CONSTRUCTION (CHECK ALL THAT APPLY):

NEW CONSTRUCTION RESIDENTIAL SINGLE-FAMILY _____ RESIDENTIAL MULTI-FAMILY _____
 CONDO MOBILE/MANUFACTURED HOME _____ COMMERCIAL INDUSTRIAL _____
 OTHER (PLEASE DESCRIBE): _____

BUILDING SIZE (IN SQUARE FEET) 25,000

COMMENTS (IF APPLICABLE PLEASE LIST NO. OF BUILDINGS AND NO. OF UNITS):

FIXTURE COUNT

BATHROOM		KITCHEN		LAUNDRY		MISC	
SHOWER/TUB COMBO	<input type="checkbox"/>	SINKS	<input type="checkbox"/>	WASHING MACHINE	<input type="checkbox"/>	HOSEBIBS	<input type="checkbox"/>
BATHTUB	<input type="checkbox"/>	TOILETS	<input type="checkbox"/>	DISHWASHER	<input type="checkbox"/>	SINKS	<input type="checkbox"/>
SHOWER	<input type="checkbox"/>	URINALS	<input type="checkbox"/>	OTHER	<input type="checkbox"/>	OTHER	<input type="checkbox"/>
OVERSIZED BATHTUB (EX: JACUZZI, SOAKER)	<input type="checkbox"/>	BIDET	<input type="checkbox"/>			POOL (SIZE)	<input type="checkbox"/>

PROPERTY OWNER SIGNATURE Keri Fowler DATE: _____
 APPLICANT / CORPORATION OFFICER SIGNATURE _____ DATE: _____
 CORPORATION NAME: _____
 OFFICERS NAME & TITLE (print) _____

I, Keri Fowler agree that I will not hold the Seabrook Sewer Department responsible for any damages to my property, which may be incurred during, or as a result of the sewer service installation.

 Property Owner or Agent with Power of Attorney (Signature)

AMOUNT PAID 800.00 CASH / CHECK # 1103 DATE RECEIVED 2-7-24 BY S.G.

TOWN OF SEABROOK
SEWER DEPARTMENT &
WASTEWATER TREATMENT FACILITY
 PO BOX 456 • WRIGHT'S ISLAND • SEABROOK, NH 03874
 PHONE (603) 474-8012 • FAX (603) 474-8014



House Service Connection Ties

Address: 85 LEDGE RD

Map: 5

Lot: 8

Seq: 703

Please provide a sketch of the service connection with the approximate length. Please indicate the name of the street and a sketch of the house. In addition please show the approximate distances from any water lines on the property:

Connection to Building

The applicant shall provide proper plumbing of building(s), which shall be in compliance with the International Plumbing Code as well as the rules and ordinances of the Town of Seabrook and the State of New Hampshire. The Town of Seabrook shall inspect and certify the plumbing, including the underground piping (before backfilling), prior to connection to the Town of Seabrook's sewer system.

—OFFICE USE ONLY—

GRANTED _____ DENIED _____ DATE _____

Board of Sewer Commissioners

REASON FOR DENIAL: _____

(CHAIRMAN)

[Signature]
Sewer Superintendent

2/13/2024
Date

AMOUNT PAID _____ CASH / CHECK # _____ DATE RECEIVED _____ BY _____

BOOK ZON BLUE MIL FROM SIDE REAR HAND MAINT PROP

MAP #5 LOT #8/60
LLOYD N. & JOAN PERRINS
65 CENTENNIAL STREET
SEABROOK, NH 03874
BOOK 4001, PAGE 1820


SMH 10.424 (12")
INV. = 52.24'
MAP #8 LOT #1
ZBF SEABROOK TRUST
66 POLAND SPRINGS
777 WEST RUTLAND AVE.
GREENWICH, CT 06030
BOOK 3726, PAGE 600

PROPOSED SM#2
SMH 97.15
INV. OUT = 52.89'

MAP #5 LOT #8/70
HARLEY REAL ESTATE DEVELOPMENT, LLC
PO BOX 202
SEABROOK, NH 03874
BOOK 4100 PAGE 1150

85 LEDGE RD
5-8-703

MAP #5 LOT #8/60
PARKER & PARKER REALTY TRUST
WILLIAM LEBRITO, TRUSTEE
JEANETTE'S REACH
APPROBATE, MA OTHERS
ROCKFORD PAGE 1069

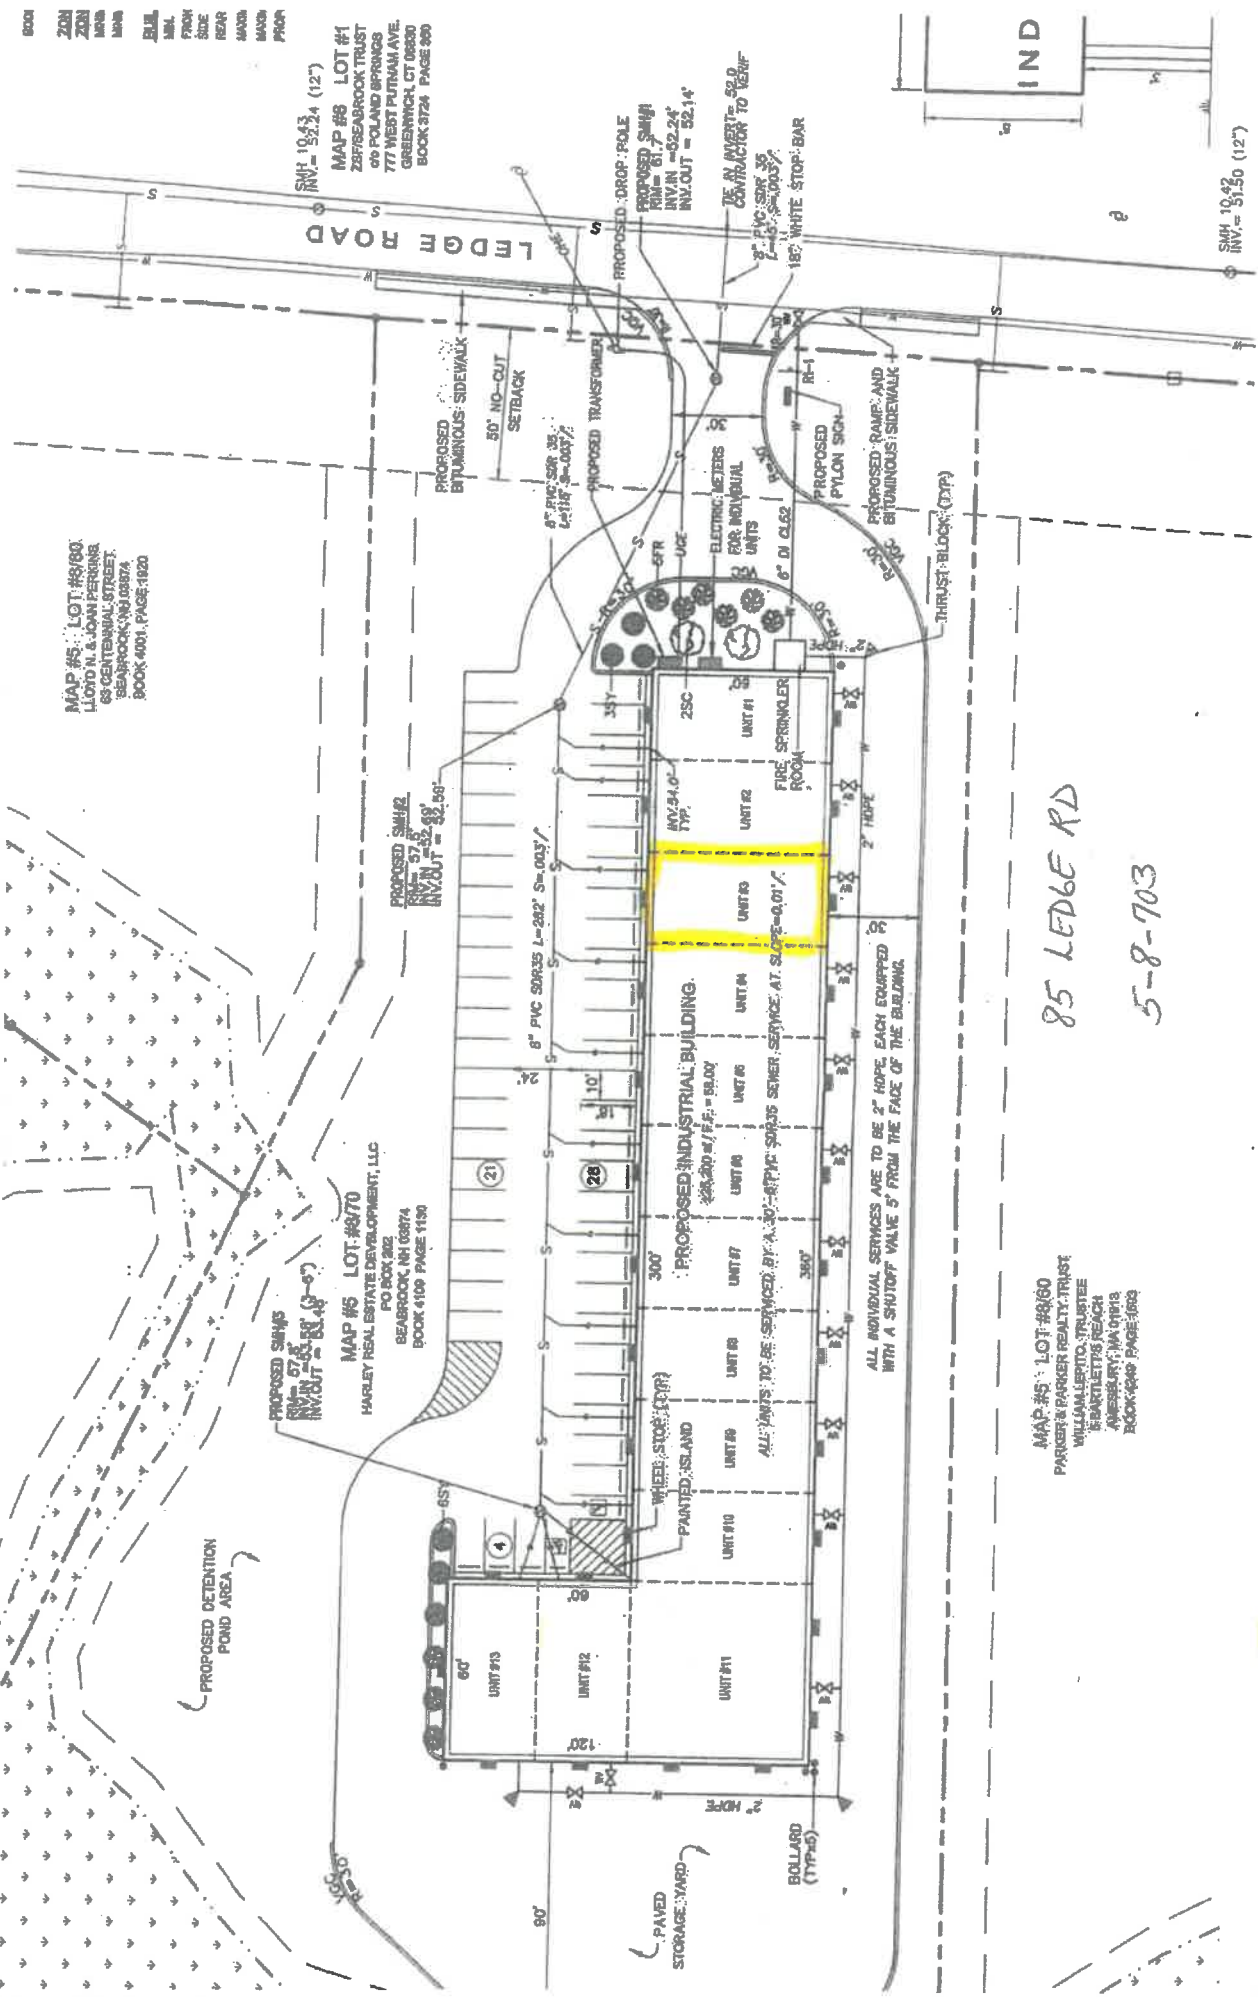

ALL INDIVIDUAL SERVICES ARE TO BE 2" HOPE, EACH EQUIPPED WITH A SHUTOFF VALVE 5' FROM THE FACE OF THE BUILDING.

Drawing Name: **SITE & UTILITIES PLAN**
Project: **LOT 70 - LEDGE ROAD**
Client: **HARLEY REAL ESTATE DEVELOPMENT, LLC
P.O. BOX 202 SEABROOK, NH 03874**

J/B Jones & Beach Engineers, Inc.
Civil Engineering Services
PO Box 219 802-772-4746
86 Portsmouth Ave. FAX: 800-772-0227
Brentwood, NH 03825 E-Mail: jonesandbeach@earthlink.net

Rev.	Date	By
1	1/13/08	AKB
0	11/07/06	NKB
Revision		

