

TOWN OF SEABROOK
SEWER DEPARTMENT &
WASTEWATER TREATMENT FACILITY
 PO BOX 456 • WRIGHT'S ISLAND • SEABROOK, NH 03874
 PHONE (603) 474-8012 • FAX (603) 474-8014



APPLICATION FOR SEWER SERVICE

DATE: 1/23/2024

APPLICANT / BUSINESS NAME CPF Builders Inc
 SERVICE ADDRESS 98 Washington St
 MAP 14 LOT 7 SEQ. _____ ZONING DISTRICT _____ IS LOT IN CURRENT USE? Y/N _____
 MAILING ADDRESS 219 Lower Collins St CITY Seabrook STATE NH ZIP 03874
 PHONE 978-476-6585 CELL SAME EMAIL Cfrancis9@yahoo.com
 PROPERTY OWNER (IF DIFFERENT THAN ABOVE) Samuel Patterson PHONE 603-300-2950

TYPE OF CONSTRUCTION (CHECK ALL THAT APPLY):

NEW CONSTRUCTION RESIDENTIAL SINGLE-FAMILY RESIDENTIAL MULTI-FAMILY _____
 CONDO _____ MOBILE/MANUFACTURED HOME _____ COMMERCIAL _____ INDUSTRIAL _____
 OTHER (PLEASE DESCRIBE): _____

BUILDING SIZE (IN SQUARE FEET) 7- 1,900

COMMENTS (IF APPLICABLE PLEASE LIST NO. OF BUILDINGS AND NO. OF UNITS):

REPLACING EXISTING HOME

FIXTURE COUNT

BATHROOM		KITCHEN		LAUNDRY		MISC	
SHOWER/TUB (COMBO)	<u>2</u>	SINKS	<u>3</u>	WASHING MACHINE	<u>1</u>	HOSEBIBS	<u>2</u>
BATH/TUB	<u>0</u>	TOILETS	<u>3</u>	DISHWASHER	<u>1</u>	BAR SINKS	<u>0</u>
SHOWER	<u>0</u>	URINALS	<u>0</u>	OTHER	<u>0</u>	POOL (SIZE)	
OVERSIZED BATH/TUB (EX: JACUZZI, SOAKER)	<u>0</u>	BIDET	<u>0</u>				

PROPERTY OWNER SIGNATURE _____

DATE: 1/23/2024

APPLICANT / CORPORATION OFFICER SIGNATURE Chris Francis

DATE: 1/23/2024

CORPORATION NAME: CPF Builders Inc

OFFICERS NAME & TITLE (print) Chris Francis, President

I, Samuel Patterson _____ agree that I will not hold the Seabrook Sewer Department responsible for any damages to my property, which may be incurred during, or as a result of the sewer service installation.

 Property Owner or Agent with Power of Attorney (Signature)


TOWN OF SEABROOK
SEWER DEPARTMENT &
WASTEWATER TREATMENT FACILITY
 PO BOX 456 • WRIGHT'S ISLAND • SEABROOK, NH 03874
 PHONE (603) 474-8012 • FAX (603) 474-8014



House Service Connection Ties

Address: 98 Washington St
 Map: 14 Lot: 7 Seq: _____

Please provide a sketch of the service connection with the approximate length. Please indicate the name of the street and a sketch of the house. In addition please show the approximate distances from any water lines on the property:

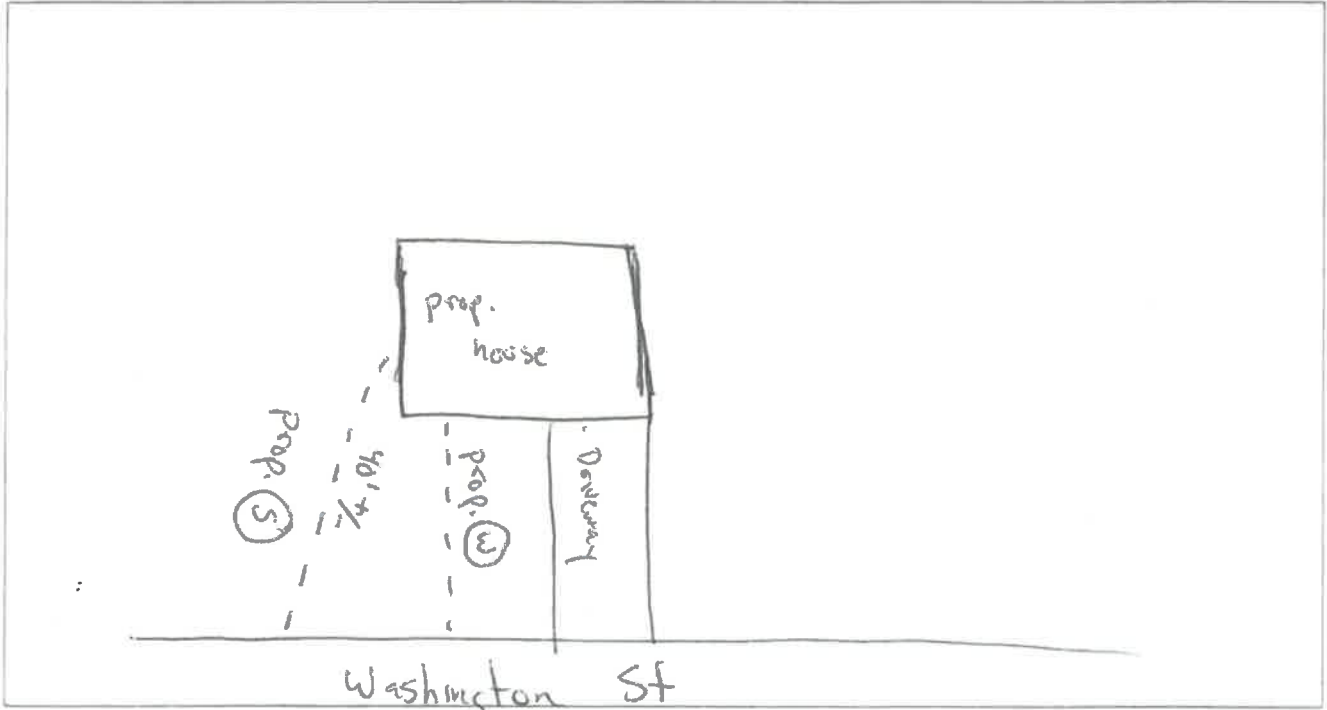

Connection to Building

The applicant shall provide proper plumbing of building(s), which shall be in compliance with the International Plumbing Code as well as the rules and ordinances of the Town of Seabrook and the State of New Hampshire. The Town of Seabrook shall inspect and certify the plumbing, including the underground piping (before backfilling), prior to connection to the Town of Seabrook's sewer system.

--OFFICE USE ONLY--

GRANTED _____ DENIED _____ DATE _____

Board of Sewer Commissioners

REASON FOR DENIAL: _____ (CHAIRMAN) _____

[Signature] _____
 Sewer Superintendent Date 1/23/24

Amount Paid \$50.00 Cash/Check# 120 Date 1-23-24 By S.G.