

**TOWN OF SEABROOK  
SEWER DEPARTMENT &  
WASTEWATER TREATMENT FACILITY**  
PO BOX 456 • WRIGHT'S ISLAND • SEABROOK, NH 03874  
PHONE (603) 474-8012 • FAX (603) 474-8014



**APPLICATION FOR SEWER SERVICE**

DATE: 3-11-24

APPLICANT / BUSINESS NAME Spednik, LLC  
 SERVICE ADDRESS 20 Adder Lane  
 MAP 3 LOT 4 SEQ. 120 ZONING DISTRICT \_\_\_\_\_ IS LOT IN CURRENT USE? Y/ N  
 MAILING ADDRESS 48 Blacksnake Rd. CITY Seabrook STATE NH ZIP 03874  
 PHONE 603 397 7570 CELL SAME EMAIL SPEDNIKLLC@gmail.com  
 PROPERTY OWNER (IF DIFFERENT THAN ABOVE) \_\_\_\_\_ PHONE \_\_\_\_\_

**TYPE OF CONSTRUCTION (CHECK ALL THAT APPLY):**

NEW CONSTRUCTION  RESIDENTIAL SINGLE-FAMILY  RESIDENTIAL MULTI-FAMILY \_\_\_\_\_  
 CONDO \_\_\_\_\_ MOBILE/MANUFACTURED HOME  COMMERCIAL \_\_\_\_\_ INDUSTRIAL \_\_\_\_\_  
 OTHER (PLEASE DESCRIBE): \_\_\_\_\_

BUILDING SIZE (IN SQUARE FEET) 1500

**COMMENTS (IF APPLICABLE PLEASE LIST NO. OF BUILDINGS AND NO. OF UNITS):**

Will connect to existing sewer line on property.

**FIXTURE COUNT**

BATHROOM		KITCHEN		LAUNDRY		Misc	
SHOWER/TUB COMBO	<input type="checkbox"/>	SINKS	<input type="checkbox"/>	WASHING MACHINE	<input type="checkbox"/>	HOSEBIBS	<input type="checkbox"/>
BATHTUB	<input type="checkbox"/>	TOILETS	<input type="checkbox"/>	DISHWASHER	<input type="checkbox"/>	BAR SINKS	<input type="checkbox"/>
SHOWER	<input type="checkbox"/>	URINALS	<input type="checkbox"/>	OTHER	<input type="checkbox"/>	POOL (SIZE)	<input type="checkbox"/>
OVERSIZED BATHTUB (EX: JACUZZI, SOAKER)	<input type="checkbox"/>	BIDET	<input type="checkbox"/>				

PROPERTY OWNER SIGNATURE \_\_\_\_\_ DATE: 3-11-24  
 APPLICANT / CORPORATION OFFICER SIGNATURE \_\_\_\_\_ DATE: \_\_\_\_\_  
 CORPORATION NAME: Spednik, LLC  
 OFFICERS NAME & TITLE (print) Steve Lago, President

I, Stephen Lago Property Owner (print) agree that I will not hold the Seabrook Sewer Department responsible for any damages to my property, which may be incurred during, or as a result of the sewer service installation.

\_\_\_\_\_  
 Property Owner or Agent with Power of Attorney (Signature)

AMOUNT PAID 50.00 CASH / CHECK # 8825 DATE RECEIVED 3-12-24 BY \_\_\_\_\_


**TOWN OF SEABROOK**  
**SEWER DEPARTMENT &**  
**WASTEWATER TREATMENT FACILITY**  
 PO BOX 456 • WRIGHT'S ISLAND • SEABROOK, NH 03874  
 PHONE (603) 474-8012 • FAX (603) 474-8014



**House Service Connection Ties**

Address: 20 Adder Lane  
 Map: 3 Lot: 4 Seq: 120

Please provide a sketch of the service connection with the approximate length. Please indicate the name of the street and a sketch of the house. In addition please show the approximate distances from any water lines on the property:

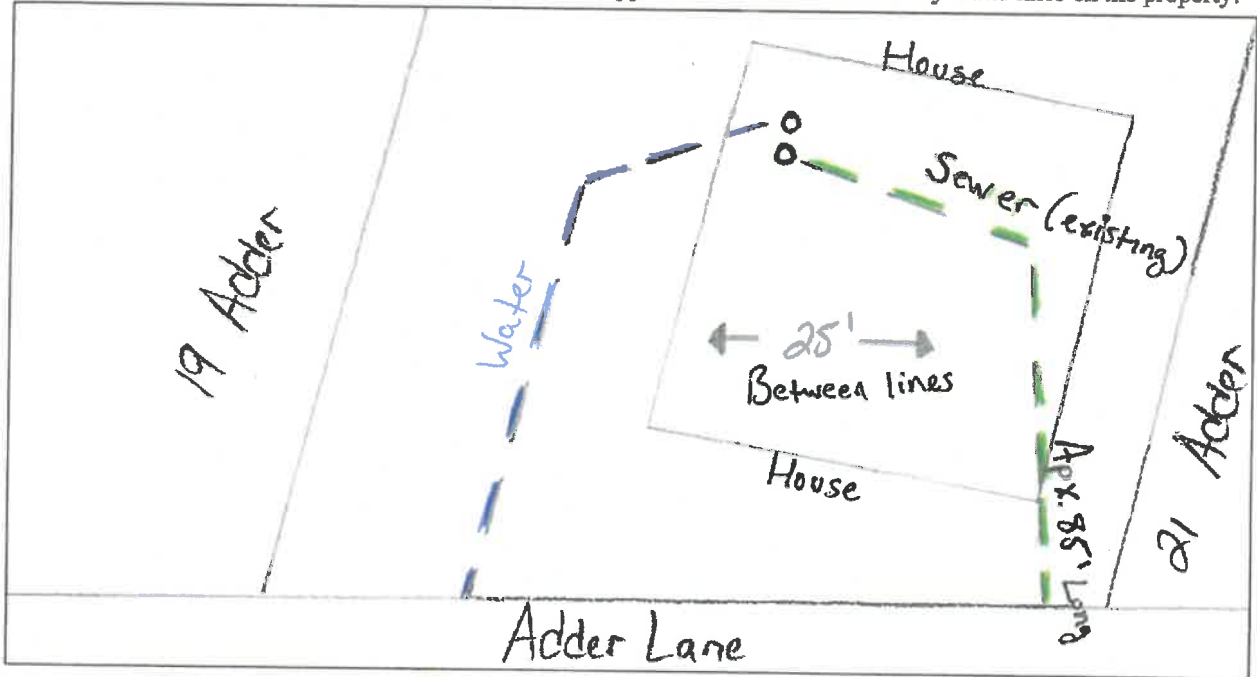

**Connection to Building**

The applicant shall provide proper plumbing of building(s), which shall be in compliance with the International Plumbing Code as well as the rules and ordinances of the Town of Seabrook and the State of New Hampshire. The Town of Seabrook shall inspect and certify the plumbing, including the underground piping (before backfilling), prior to connection to the Town of Seabrook's sewer system.

**--OFFICE USE ONLY--**

GRANTED \_\_\_\_\_ DENIED \_\_\_\_\_ DATE \_\_\_\_\_

**Board of Sewer Commissioners**

REASON FOR DENIAL: \_\_\_\_\_ (CHAIRMAN) \_\_\_\_\_

*[Signature]* 3/13/24  
 Sewer Superintendent Date

AMOUNT PAID \_\_\_\_\_ CASH / CHECK # \_\_\_\_\_ DATE RECEIVED \_\_\_\_\_ BY \_\_\_\_\_