



TOWN OF SEABROOK PUBLIC WATER SYSTEM

550 Route 107 ~ PO Box 456, Seabrook, NH 03874

Phone: (603) 474-9921 Fax: (603) 474-3399

WATER SERVICE APPLICATION

APPLICANT INFO SAME AS LANDOWNER? YES NO DATE: 11/7/24

APPLICANT NAME/CORPORATION George Ross 603-760-2386		LANDOWNER/BILLING NAME George Ross	
APPLICANT ADDRESS 15 Railroad Ave		BILLING ADDRESS NH - Seabrook	
CITY/STATE NH	HOME/WORK PHONE 603-760-2386	CITY/STATE	HOME/WORK PHONE
ZIP CODE 03874	WORK/OTHER PHONE	ZIP CODE	WORK/OTHER PHONE
E-MAIL ADDRESS OF APPLICANT		E-MAIL ADDRESS OF LANDOWNER	

SERVICE ADDRESS: 15 Railroad Ave ASSESSOR'S MAP-LOT-SEQ: 8-106-1

TYPE OF CONSTRUCTION: (Check All That Apply) NEW CONSTRUCTION RESIDENTIAL SINGLE FAMILY MULTI-FAMILY CONDO
 MOBILE/MANUFACTURED HOME COMMERCIAL INDUSTRIAL (Please Describe) New line (Emergency Replacement)

*UNDER 'ADDITIONAL COMMENTS' SECTION, LIST NO. OF BUILDINGS AND NO. OF UNITS IN EACH BUILDING, IF APPLICABLE

NO. OF STORIES IN BUILDING: 1 BUILDING SIZE IN SQUARE FEET: TOTAL PARCEL AREA IN SQUARE FEET:

FIRE DEPARTMENT REQUIREMENTS: NONE SPRINKLE ALL SPRINKLE GARAGE ONLY

FIRE HYDRANTS REQUIRED: NONE PUBLIC (NO. OF HYDRANTS) PRIVATE (NO. OF HYDRANTS)

IS THERE A WELL ON THE PROPERTY? YES NO USING RECYCLED WATER? YES NO

WILL A PUMP BE USED TO BOOST PRESSURE? YES - FIRE SERVICE YES - DOMESTIC SERVICE NO

WILL THERE BE LANDSCAPE IRRIGATION? YES NO IF YES, NUMBER OF SPRINKLER HEADS:

FLOW OF EACH SPRINKLER HEAD IN GPM: TOTAL IRRIGATED AREA IN SQUARE FEET:

IF NON-RESIDENTIAL, DESCRIBE BUSINESS TYPE OR USAGE OF LOT:

SERVICES - LIST ALL REQUIRED PER PARCEL

POTABLE OR RECYCLED	SERVICE USE (RESIDENTIAL, FIRE, IRRIGATION, ETC.)	LATERAL SIZE	METER SIZE	MAX DEMAND IN GPM	ANTICIPATED DATE OF METER INSTALLATION
potable	residential	-	5/8"	-	-

FIXTURE UNIT COUNT - COMPLETE THE QUANTITY OF THE FOLLOWING

BATHROOM:		KITCHEN:		LAUNDRY ROOM:		MISC/OTHER:	
TUBS/SHOWERS	JACUZZI TUBS	DISHWASHERS	SINKS	CLOTHES WASHERS	SINKS	HOSEBIBS	BAR SINKS
TUBS ONLY	TOILETS		2			POOL (SIZE:)	
SHOWERS ONLY	URINALS					DESCRIBE:	
SINKS	BIDETS						

bedrooms 3

LAND OWNER'S SIGNATURE _____ DATE 11-7-24

By signing above, I agree I will not hold the Seabrook Water Department responsible for any damages to my property, which may be incurred during, or as a result of the water installation. **ALSO: THIS APPLICATION WILL EXPIRE 2 YEARS AFTER APPROVAL BY THE BOARD OF SELECTMEN and THE FEE WILL BE NONREFUNDABLE

CORPORATION NAME _____ OFFICER'S NAME & TITLE (PRINT) _____

APPLICANT/CORPORATION'S OFFICER SIGNATURE George Ross _____ DATE 11-7-24

ACCOUNT # 146450



TOWN OF SEABROOK PUBLIC WATER SYSTEM


550 Route 107 ~ PO Box 456, Seabrook, NH 03874
Phone: (603) 474-9921 Fax: (603) 474-3399

WATER SERVICE APPLICATION

Service Connection Ties

Address: 15 Railroad Ave

Please provide a sketch of the service connection with the approximate length. Please indicate the name of the street and a sketch of the house. In addition, please show the approximate distances from any sewer lines on the property.

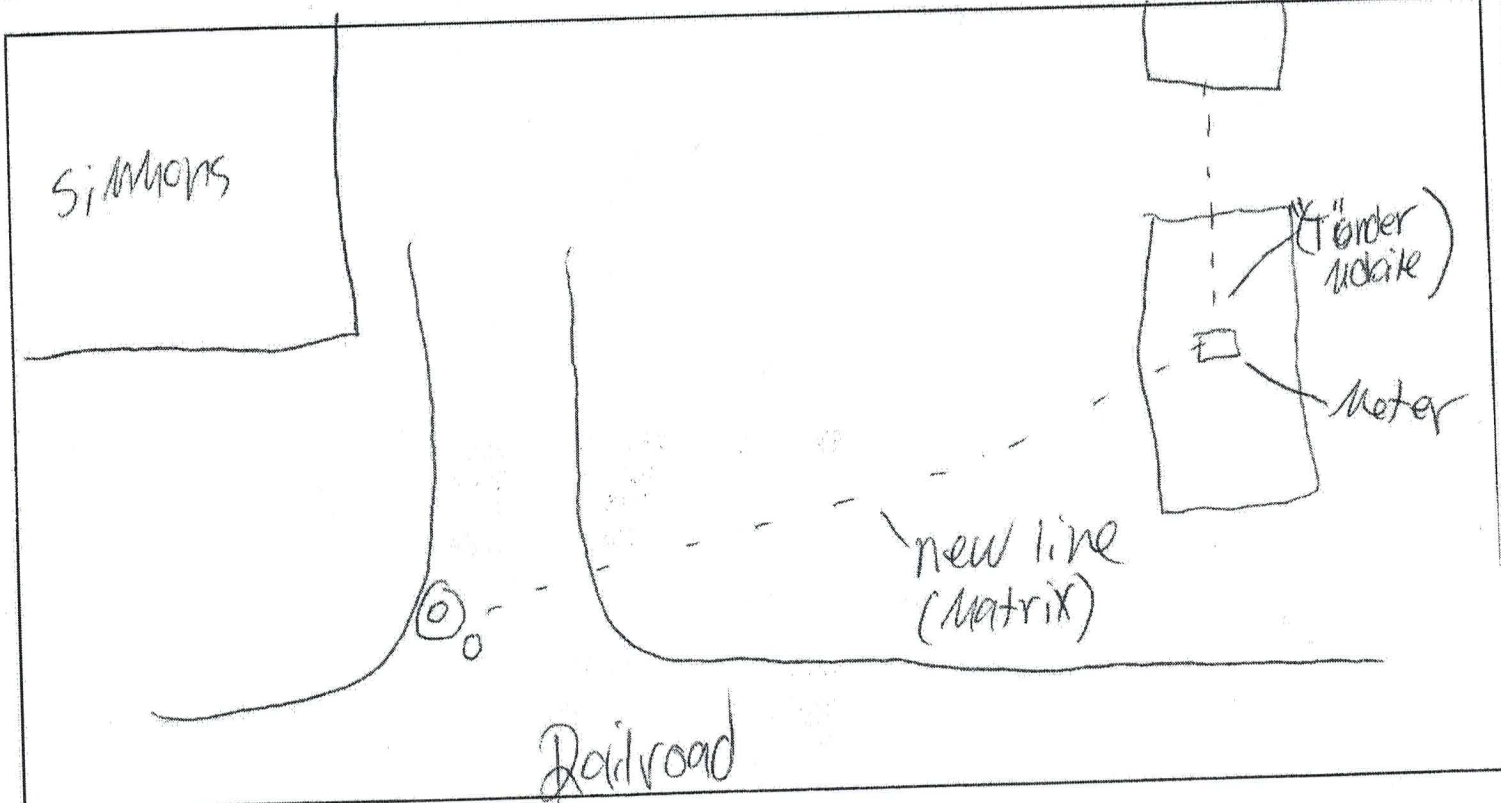

Connection to Building

The applicant shall provide proper plumbing of building(s), which shall be in compliance with the International Plumbing Code as well as the Rules and Ordinances of the Town of Seabrook and the State of New Hampshire. Water lines are required to be inspected by the Water Department before backfilling.

-OFFICE USE ONLY-

GRANTED ___ DENIED ___ DATE _____

Board of Water Commissioners

REASON FOR DENIAL: _____

(Chairman)

[Signature]
Water Superintendent

11/16/24
Date

AMOUNT PAID \$ 50.00

CASH/CHECK [initials]

DATE RECEIVED 11/11/24

BY [Signature]