

TOWN OF SEABROOK PUBLIC WATER SYSTEM

550 Route 107 ~ PO Box 456, Seabrook, NH 03874

Phone: (603) 474-9921 Fax: (603) 474-3399

WATER SERVICE APPLICATION

APPLICANT INFO SAME AS LANDOWNER? YES NO DATE: 12/10/24

APPLICANT NAME/CORPORATION <u>Ann Willwerth</u>		LANDOWNER/BILLING NAME <u>Ann Willwerth</u>	
APPLICANT ADDRESS <u>PO Box 644</u>	HOME/WORK PHONE <u>603-944-1138</u>	BILLING ADDRESS <u>PO Box 644</u>	HOME/WORK PHONE <u>603-944-1138</u>
CITY/STATE <u>Seabrook NH</u>	ZIP CODE <u>03874</u>	CITY/STATE <u>Seabrook NH</u>	ZIP CODE <u>03874</u>
E-MAIL ADDRESS OF APPLICANT <u>lawillwerth@comcast.net</u>		E-MAIL ADDRESS OF LANDOWNER <u>lawillwerth@comcast.net</u>	

SERVICE ADDRESS: 291 A So. Main St ASSESSOR'S MAP-LOT-SEQ: 17-16-1

TYPE OF CONSTRUCTION: (Check All That Apply) NEW CONSTRUCTION RESIDENTIAL SINGLE FAMILY MULTI-FAMILY CONDO

MOBILE/MANUFACTURED HOME COMMERCIAL INDUSTRIAL (Please Describe) *Emergency Line Repair

*UNDER 'ADDITIONAL COMMENTS' SECTION, LIST NO. OF BUILDINGS AND NO. OF UNITS IN EACH BUILDING, IF APPLICABLE

NO. OF STORIES IN BUILDING: 1 BUILDING SIZE IN SQUARE FEET: _____ TOTAL PARCEL AREA IN SQUARE FEET: _____

FIRE DEPARTMENT REQUIREMENTS NONE SPRINKLE ALL SPRINKLE GARAGE ONLY

FIRE HYDRANTS REQUIRED NONE PUBLIC (NO. OF HYDRANTS _____) PRIVATE (NO. OF HYDRANTS _____)

IS THERE A WELL ON THE PROPERTY? YES NO USING RECYCLED WATER? YES NO

WILL A PUMP BE USED TO BOOST PRESSURE? YES - FIRE SERVICE YES - DOMESTIC SERVICE NO

WILL THERE BE LANDSCAPE IRRIGATION? YES NO IF YES, NUMBER OF SPRINKLER HEADS: _____

FLOW OF EACH SPRINKLER HEAD IN GPM: _____ TOTAL IRRIGATED AREA IN SQUARE FEET: _____

IF NON-RESIDENTIAL, DESCRIBE BUSINESS TYPE OR USAGE OF LOT: _____

SERVICES - LIST ALL REQUIRED PER PARCEL

POTABLE OR RECYCLED	SERVICE USE (RESIDENTIAL, FIRE, IRRIGATION, ETC.)	LATERAL SIZE	METER SIZE	MAX DEMAND IN GPM	ANTICIPATED DATE OF METER INSTALLATION
potable	residential	-	5/8"	-	-

FIXTURE UNIT COUNT - COMPLETE THE QUANTITY OF THE FOLLOWING

BATHROOM:		KITCHEN:		LAUNDRY ROOM:		MISC/OTHER:	
TUBS/SHOWERS	JACUZZI TUBS	DISHWASHERS	SINKS	CLOTHES WASHERS	SINKS	HOSE/BIBS	
TUBS ONLY	TOILETS			# OF BEDROOMS:		BAR SINKS	
SHOWERS ONLY	URINALS					POOL (SIZE: _____)	
SINKS	BIDETS					DESCRIBE:	

LAND OWNER'S SIGNATURE [Signature] DATE 12/10/24

By signing above, I agree I will not hold the Seabrook Water Department responsible for any damages to my property, which may be incurred during, or as a result of the water installation.

****ALSO: THIS APPLICATION WILL EXPIRE 2 YEARS AFTER APPROVAL BY THE BOARD OF SELECTMEN and THE FEE WILL BE NONREFUNDABLE**

CORPORATION NAME [Signature] OFFICER'S NAME & TITLE (PRINT) _____

APPLICANT/CORPORATION'S OFFICER SIGNATURE _____ DATE 12/10/24

ACCOUNT # 162050



TOWN OF SEABROOK PUBLIC WATER SYSTEM

550 Route 107 ~ PO Box 456, Seabrook, NH 03874

Phone: (603) 474-9921 Fax: (603) 474-3399


WATER SERVICE APPLICATION

Service Connection Ties

Address: 291 A So. main St.

Please provide a sketch of the service connection with the approximate length. Please indicate the name of the street and a sketch of the house. In addition, please show the approximate distances from any sewer lines on the property.

If new construction, please attach a copy of plans

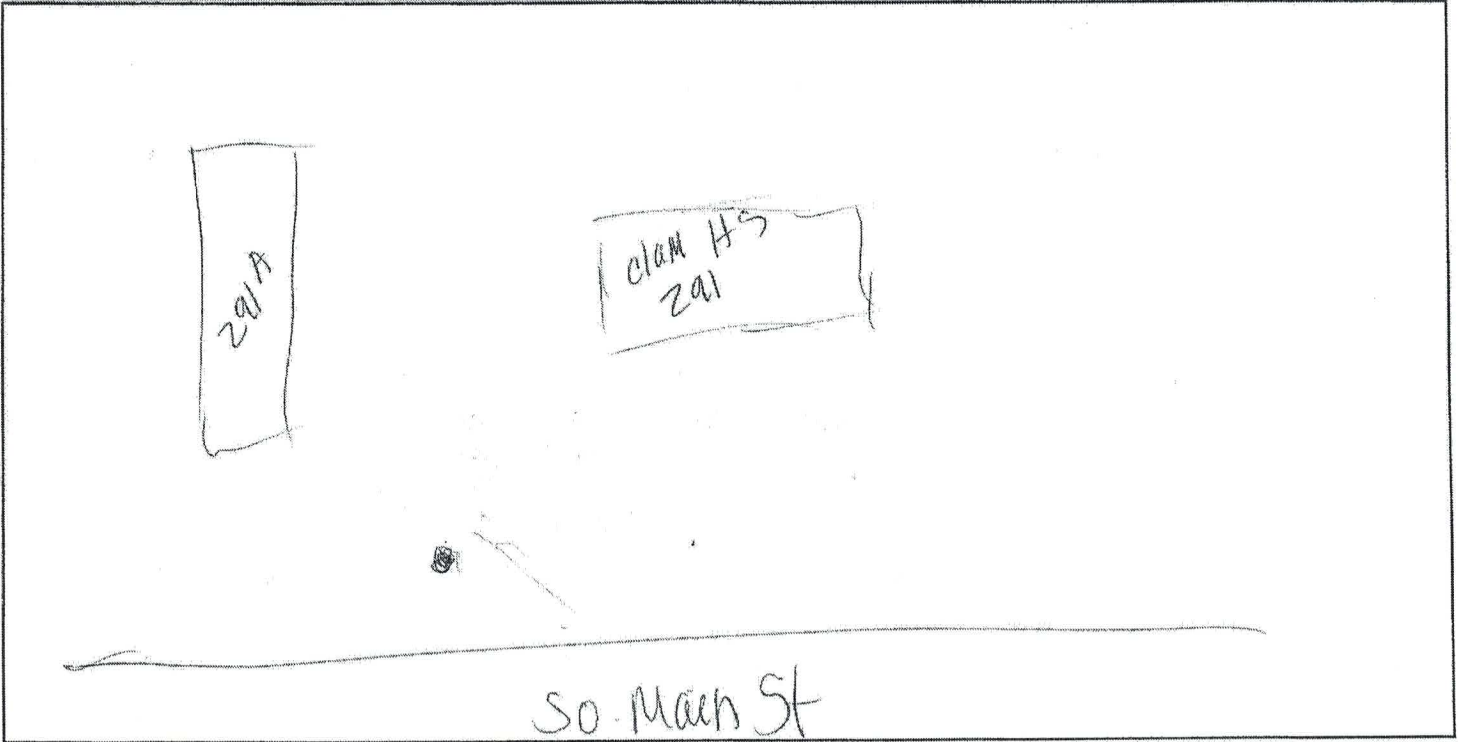

Connection to Building

***The applicant shall provide proper plumbing of building(s), which shall be in compliance with the International Plumbing Code as well as the Rules and Ordinances of the Town of Seabrook and the State of New Hampshire.

Water lines are required to be inspected by the Water Department before backfilling.***

-OFFICE USE ONLY-

GRANTED ___ DENIED ___ DATE _____

Board of Water Commissioners

REASON FOR DENIAL: _____

(Chairman)

[Signature]
Water Superintendent

12/10/24
Date

AMOUNT PAID: \$50.00

CASH/CHECK # 3747

DATE RECEIVED: 12/10/24

BY: *[Signature]*