



# TOWN OF SEABROOK PUBLIC WATER SYSTEM

550 Route 107 ~ PO Box 456, Seabrook, NH 03874

Phone: (603) 474-9921 Fax: (603) 474-3399

## WATER SERVICE APPLICATION

APPLICANT INFO SAME AS LANDOWNER?

☒ YES

☐ NO

DATE

1/18/25

APPLICANT NAME/CORPORATION

Don Crawford

APPLICANT ADDRESS

18 Nashua St

HOME/WORK PHONE

(603) 474-9977

CITY/STATE

Seabrook, NH

ZIP CODE

03874

WORK/OTHER PHONE

E-MAIL ADDRESS OF APPLICANT

DonCraw1949@gmail.com

LANDOWNER/BILLING NAME

BILLING ADDRESS

Same

HOME/WORK PHONE

CITY/STATE

ZIP CODE

WORK/OTHER PHONE

E-MAIL ADDRESS OF LANDOWNER

SERVICE ADDRESS:

ASSESSOR'S MAP LOT SEQ:

TYPE OF CONSTRUCTION (Check all that apply)

NEW CONSTRUCTION

☒ RESIDENTIAL

SINGLE FAMILY

MULTI-FAMILY

CONDO

MOBILE/MANUFACTURED HOME

COMMERCIAL

INDUSTRIAL

(Please Describe)

emergency line repair

"UNDER 'ADDITIONAL COMMENTS' SECTION, LIST NO. OF BUILDINGS AND NO. OF UNITS IN EACH BUILDING, IF APPLICABLE"

NO. OF STORIES IN BUILDING:

2

BUILDING SIZE IN SQUARE FEET:

20 x 30

TOTAL PARCEL AREA IN SQUARE FEET:

4,800

FIRE DEPARTMENT REQUIREMENTS

NONE

SPRINKLE ALL

SPRINKLE GARAGE ONLY

FIRE HYDRANTS REQUIRED

NONE

PUBLIC (NO. OF HYDRANTS)

PRIVATE (NO. OF HYDRANTS)

IS THERE A WELL ON THE PROPERTY?

YES

☒ NO

USING RECYCLED WATER?

YES

NO

WILL A PUMP BE USED TO BOOST PRESSURE?

YES - FIRE SERVICE

YES - DOMESTIC SERVICE

NO

WILL THERE BE LANDSCAPE IRRIGATION?

YES

NO

IF YES, NUMBER OF SPRINKLER HEADS:

FLOW OF EACH SPRINKLER HEAD IN GPM:

TOTAL IRRIGATED AREA IN SQUARE FEET:

IF NON-RESIDENTIAL, DESCRIBE BUSINESS TYPE OR USAGE OF LOT:

### SERVICES - LIST ALL REQUIRED PER PARCEL

| POTABLE OR RECYCLED | SERVICE USE<br>(RESIDENTIAL, FIRE, IRRIGATION, ETC.) | LATERAL SIZE | METER SIZE | MAX DEMAND<br>IN GPM | ANTICIPATED DATE OF<br>METER INSTALLATION |
|---------------------|------------------------------------------------------|--------------|------------|----------------------|-------------------------------------------|
| potable             | residential                                          |              | 5/8"       |                      |                                           |

### FIXTURE UNIT COUNT - COMPLETE THE QUANTITY OF THE FOLLOWING

#### BATHROOM:

TUBS/SHOWERS

1

JACUZZI TUBS

TUBS ONLY

1

TOILETS

SHOWERS ONLY

URINALS

SINKS

BIDETS

#### KITCHEN:

DISHWASHERS

1

SINKS

1

#### LAUNDRY ROOM:

CLOTHES WASHERS

SINKS

# OF BEDROOMS:

#### MISC/OTHER:

HOSE BIBS

BAR SINKS

POOL (SIZE:)

DESCRIBE:

LAND OWNER'S SIGNATURE

Don W Crawford

DATE

1-8-25

By signing above, I agree I will not hold the Seabrook Water Department responsible for any damages to my property, which may be incurred during, or as a result of the water installation.

\*\*ALSO: THIS APPLICATION WILL EXPIRE 2 YEARS AFTER APPROVAL BY THE BOARD OF SELECTMEN and THE FEE WILL BE NONREFUNDABLE.

CORPORATION NAME

OFFICER'S NAME & TITLE (PRINT)

APPLICANT/CORPORATION'S OFFICER SIGNATURE

Don W Crawford

DATE

1-18-25

ACCOUNT #

036150



# TOWN OF SEABROOK PUBLIC WATER SYSTEM

550 Route 107 ~ PO Box 456, Seabrook, NH 03874

Phone: (603) 474-9921 Fax: (603) 474-3399

## WATER SERVICE APPLICATION


### Service Connection Ties

Address

18 Nashua St

Please provide a sketch of the service connection with the approximate length. Please indicate the name of the street and a sketch of the house. In addition, please show the approximate distances from any sewer lines on the property.

"If new construction, please attach a copy of plans."

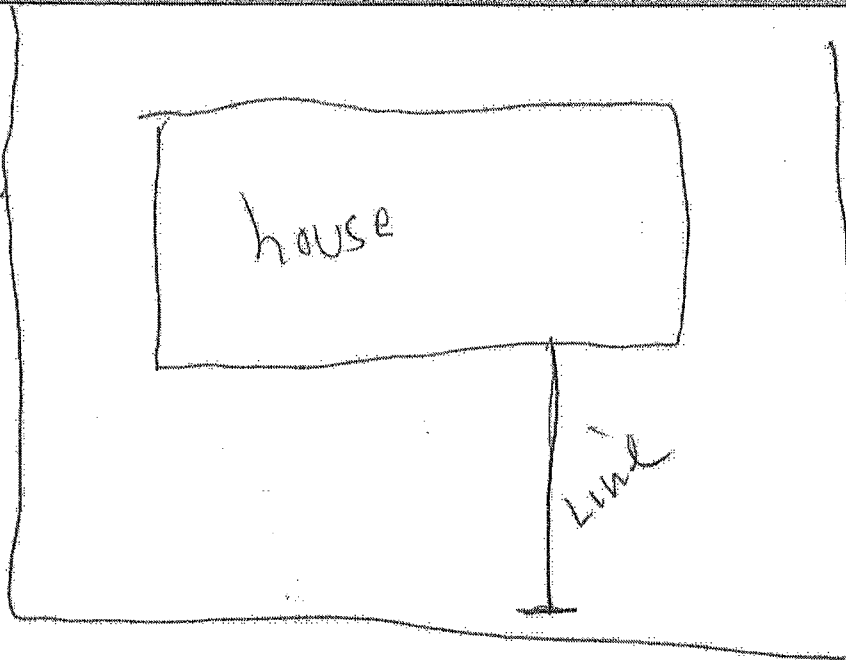

### Connection to Building

\*\*\*The applicant shall provide proper plumbing of building(s), which shall be in compliance with the International Plumbing Code as well as the Rules and Ordinances of the Town of Seabrook and the State of New Hampshire.

Water lines are required to be inspected by the Water Department before backfilling.\*\*\*

### -OFFICE USE ONLY-

GRANTED \_\_\_\_\_ DENIED \_\_\_\_\_ DATE \_\_\_\_\_

Board of Water Commissioners

REASON FOR DENIAL: \_\_\_\_\_

(Chairman)

Water Superintendent

1/9/25

Date

AMOUNT PAID: \$100

CASH/CHECK #

DATE RECEIVED

1-8-25

BY: MS