



TOWN OF SEABROOK PUBLIC WATER SYSTEM

550 Route 107 ~ PO Box 456, Seabrook, NH 03874

Phone: (603) 474-9921 Fax: (603) 474-3399

WATER SERVICE APPLICATION

APPLICANT INFO SAME AS LANDOWNER? ☒ YES ☐ NO		DATE <u>7/17/25</u>	
APPLICANT NAME/CORPORATION <u>LeeAnn Waterman</u>		LANDOWNER/BILLING NAME <u>" "</u>	
APPLICANT ADDRESS <u>3 Fowler Brook Rd</u>		BILLING ADDRESS <u>" "</u>	
CITY/STATE <u>Seabrook, NH</u>		CITY/STATE <u>" "</u>	
ZIP CODE <u>03874</u>		ZIP CODE <u>" "</u>	
E-MAIL ADDRESS OF APPLICANT <u>lwwaterman623@gmail.com</u>		E-MAIL ADDRESS OF LANDOWNER <u>" "</u>	

SERVICE ADDRESS <u>3 Fowler Brook Rd</u>	ASSESSORS MAP LOT SEC. <u>13-16-30</u>
TYPE OF CONSTRUCTION (Check all that apply)	RESIDENTIAL SINGLE FAMILY MULTI-FAMILY CONDO
MOBILE/MANUFACTURED HOME COMMERCIAL INDUSTRIAL	(Please Describe) <u>Move existing meter</u>
*UNDER 'ADDITIONAL COMMENTS' SECTION, LIST NO. OF BUILDINGS AND NO. OF UNITS IN EACH BUILDING, IF APPLICABLE	

NO. OF STORIES IN BUILDING: <u>2</u>	BUILDING SIZE IN SQUARE FEET: _____	TOTAL PARCEL AREA IN SQUARE FEET: _____
FIRE DEPARTMENT REQUIREMENTS	NONE SPRINKLE ALL	SPRINKLE GARAGE ONLY
FIRE HYDRANTS REQUIRED	NONE PUBLIC (NO. OF HYDRANTS _____)	PRIVATE (NO. OF HYDRANTS _____)
IS THERE A WELL ON THE PROPERTY?	YES ☒ NO	USING RECYCLED WATER? YES NO
WILL A PUMP BE USED TO BOOST PRESSURE?	YES - FIRE SERVICE YES - DOMESTIC SERVICE NO	
WILL THERE BE LANDSCAPE IRRIGATION?	YES ☒ NO IF YES, NUMBER OF SPRINKLER HEADS: _____	
FLOW OF EACH SPRINKLER HEAD IN GPM: _____	TOTAL IRRIGATED AREA IN SQUARE FEET: _____	
IF NON-RESIDENTIAL, DESCRIBE BUSINESS TYPE OR USAGE OF LOT: _____		

SERVICES - LIST ALL REQUIRED PER PARCEL					
POTABLE OR RECYCLED	SERVICE USE (RESIDENTIAL, FIRE, IRRIGATION, ETC.)	LATERAL SIZE	METER SIZE	MAX DEMAND IN GPM	ANTICIPATED DATE OF METER INSTALLATION
potable	residential	"	6/8"	"	"

FIXTURE UNIT COUNT - COMPLETE THE QUANTITY OF THE FOLLOWING					
BATHROOM:		KITCHEN:		LAUNDRY ROOM:	
TUBS/SHOWERS	JACUZZI TUBS	DISHWASHERS	CLOTHES WASHERS	MISC/OTHER:	
TUBS ONLY	TOILETS	SINKS	SINKS	HOSEBIBS	
SHOWERS ONLY	URINALS		# OF BEDROOMS:	BAR SINKS	
SINKS	BIDETS		<u>3</u>	POOL (SIZE: _____)	
				DESCRIBE:	

LAND OWNER'S SIGNATURE LeeAnn Waterman DATE 7/17/25

By signing above, I agree I will not hold the Seabrook Water Department responsible for any damages to my property, which may be incurred during, or as a result of the water installation.

*ALSO: THIS APPLICATION WILL EXPIRE 2 YEARS AFTER APPROVAL BY THE BOARD OF SELECTMEN and THE FEE WILL BE NONREFUNDABLE

CORPORATION NAME OFFICER'S NAME & TITLE (PRINT)

APPLICANT/CORPORATION'S OFFICER'S SIGNATURE DATE

ACCOUNT 070220



TOWN OF SEABROOK PUBLIC WATER SYSTEM

550 Route 107 ~ PO Box 456, Seabrook, NH 03874

Phone: (603) 474-9921 Fax: (603) 474-3399

WATER SERVICE APPLICATION

Service Connection Ties

Address 13 Fowler Brook Rd

Please provide a sketch of the service connection with the approximate length. Please indicate the name of the street and a sketch of the house. In addition, please show the approximate distances from any sewer lines on the property. If new construction, please attach a copy of plans.

*Please
See Attached*

Connection to Building

The applicant shall provide proper plumbing of building(s), which shall be in compliance with the International Plumbing Code as well as the Rules and Ordinances of the Town of Seabrook and the State of New Hampshire. Water lines are required to be inspected by the Water Department before backfilling.

-OFFICE USE ONLY-

GRANTED _____ DENIED _____ DATE _____

Board of Water Commissioners

REASON FOR DENIAL: _____

(Chairman)

[Signature]
Water Superintendent

7/7/25

Date

AMOUNT PAID

\$50.00

WATER CHARGE


4/4

DATE PAID

7/7/25

AD

COUNCIL OF CHURCHES			
CHURCH	TYPE	PERIOD CODE	CODE
1	1000	1000	1000

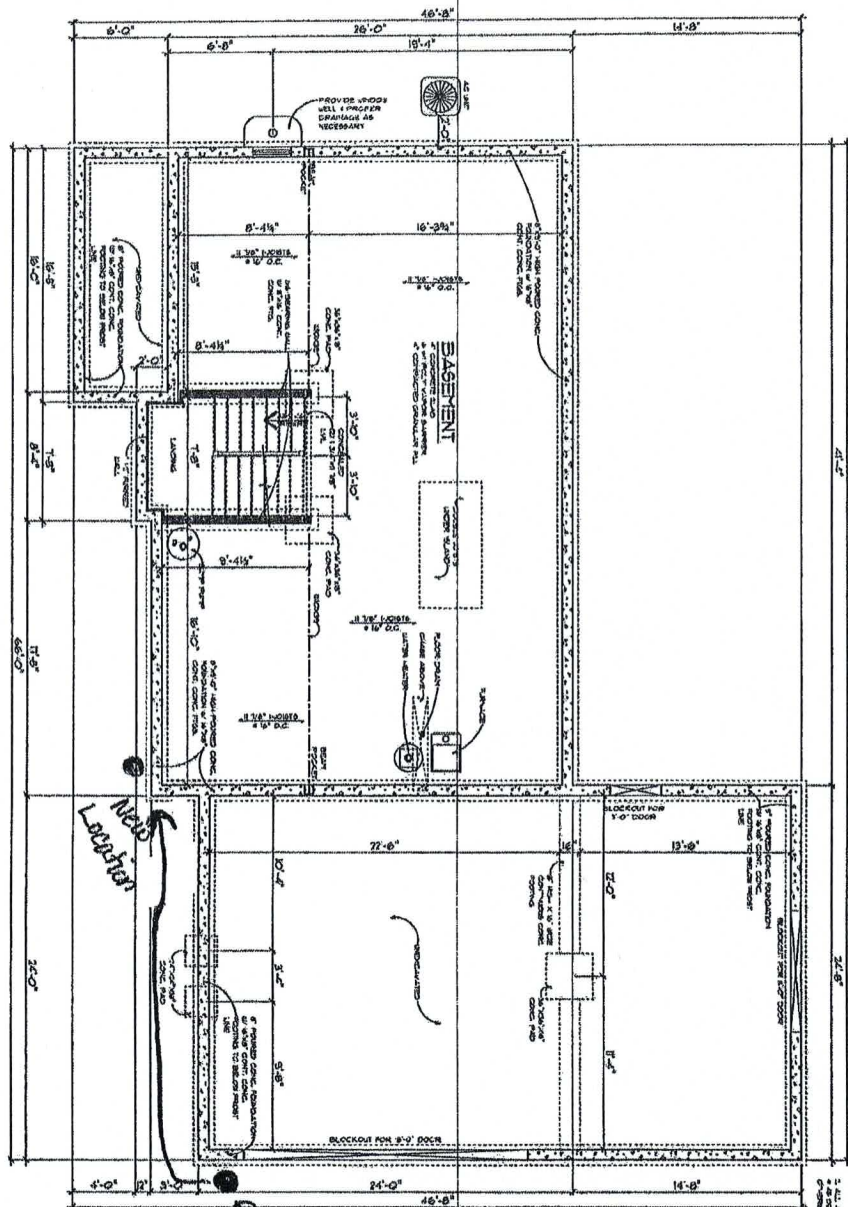

FOUNDATION PLAN