



TOWN OF SEABROOK PUBLIC WATER SYSTEM

550 Route 107 ~ PO Box 456, Seabrook, NH 03874

Phone: (603) 474-9921 Fax: (603) 474-3399

WATER SERVICE APPLICATION

APPLICANT INFO SAME AS LANDOWNER? ☒ YES ☐ NO		DATE: 8/18/25	
APPLICANT NAME/CORPORATION: Darrin Young		LANDOWNER/BILLING NAME:	
APPLICANT ADDRESS: 38 Ledge Rd		BILLING ADDRESS:	
CITY/STATE: Seabrook NH 03874		CITY/STATE:	
ZIP CODE: 03874		ZIP CODE:	
WORK/OTHER PHONE: (603) 274-1894		WORK/OTHER PHONE:	
E-MAIL ADDRESS OF APPLICANT: darrinyoung67@yahoo.com		E-MAIL ADDRESS OF LANDOWNER:	

SERVICE ADDRESS: 38 Ledge Rd	ASSESSOR'S MAP LOT SEQ: 3-6-8
TYPE OF CONSTRUCTION (Check All That Apply): ☒ NEW CONSTRUCTION ☒ RESIDENTIAL ☐ SINGLE FAMILY ☐ MULTI-FAMILY ☐ CONDO ☐ MOBILE/MANUFACTURED HOME ☐ COMMERCIAL ☐ INDUSTRIAL ☐ (Please Describe) Emergency Line Repair	
*UNDER 'ADDITIONAL COMMENTS' SECTION, LIST NO. OF BUILDINGS AND NO. OF UNITS IN EACH BUILDING, IF APPLICABLE	

NO. OF STORIES IN BUILDING: 1	BUILDING SIZE IN SQUARE FEET: 1440	TOTAL PARCEL AREA IN SQUARE FEET: 63,000?
FIRE DEPARTMENT REQUIREMENTS: NONE	SPRINKLE ALL	SPRINKLE GARAGE ONLY
FIRE HYDRANTS REQUIRED: NONE	PUBLIC (NO. OF HYDRANTS: 1)	PRIVATE (NO. OF HYDRANTS: 0)
IS THERE A WELL ON THE PROPERTY? ☒ YES ☐ NO	USING RECYCLED WATER? YES ☐ NO ☒	
WILL A PUMP BE USED TO BOOST PRESSURE? YES - FIRE SERVICE ☐ YES - DOMESTIC SERVICE ☒		
WILL THERE BE LANDSCAPE IRRIGATION? YES ☒ NO ☐	IF YES, NUMBER OF SPRINKLER HEADS: 0	
FLOW OF EACH SPRINKLER HEAD IN GPM:	TOTAL IRRIGATED AREA IN SQUARE FEET:	
IF NON-RESIDENTIAL, DESCRIBE BUSINESS TYPE OR USAGE OF LOT:		

SERVICES - LIST ALL REQUIRED PER PARCEL					
POTABLE OR RECYCLED	SERVICE USE (RESIDENTIAL, FIRE, IRRIGATION, ETC.)	LATERAL SIZE	METER SIZE	MAX DEMAND IN GPM	ANTICIPATED DATE OF METER INSTALLATION
potable	residential	-	5/8"	-	-

FIXTURE UNIT COUNT - COMPLETE THE QUANTITY OF THE FOLLOWING			
BATHROOM:	KITCHEN:	LAUNDRY ROOM:	MISC/OTHER:
TUBS/SHOWERS:	DISHWASHERS:	CLOTHES WASHERS:	HOSE BIBS:
TUBS ONLY:	SINKS:	SINKS:	BAR SINKS:
SHOWERS ONLY:		# OF BEDROOMS:	POOL (SIZE:)
SINKS:			DESCRIBE:
JACUZZI TUBS:			
TOILETS:			
URINALS:			
BIDETS:			

LAND OWNER'S SIGNATURE:	DATE: 8/18/25
By signing above, I agree I will not hold the Seabrook Water Department responsible for any damages to my property, which may be incurred during, or as a result of the water installation.	
*ALSO: THIS APPLICATION WILL EXPIRE 2 YEARS AFTER APPROVAL BY THE BOARD OF SELECTMEN and THE FEE WILL BE NONREFUNDABLE.	

CORPORATION NAME:	OFFICER'S NAME & TITLE (PRINT):
APPLICANT/CORPORATION'S OFFICER SIGNATURE:	DATE: 8/18/25

ACCOUNT # 128400



TOWN OF SEABROOK PUBLIC WATER SYSTEM

550 Route 107 ~ PO Box 456, Seabrook, NH 03874

Phone: (603) 474-9921 Fax: (603) 474-3399

WATER SERVICE APPLICATION


Service Connection Ties

Address:

38 Ledge Rd

Please provide a sketch of the service connection with the approximate length. Please indicate the name of the street and a sketch of the house. In addition, please show the approximate distances from any sewer lines on the property.

"If new construction, please attach a copy of plans"

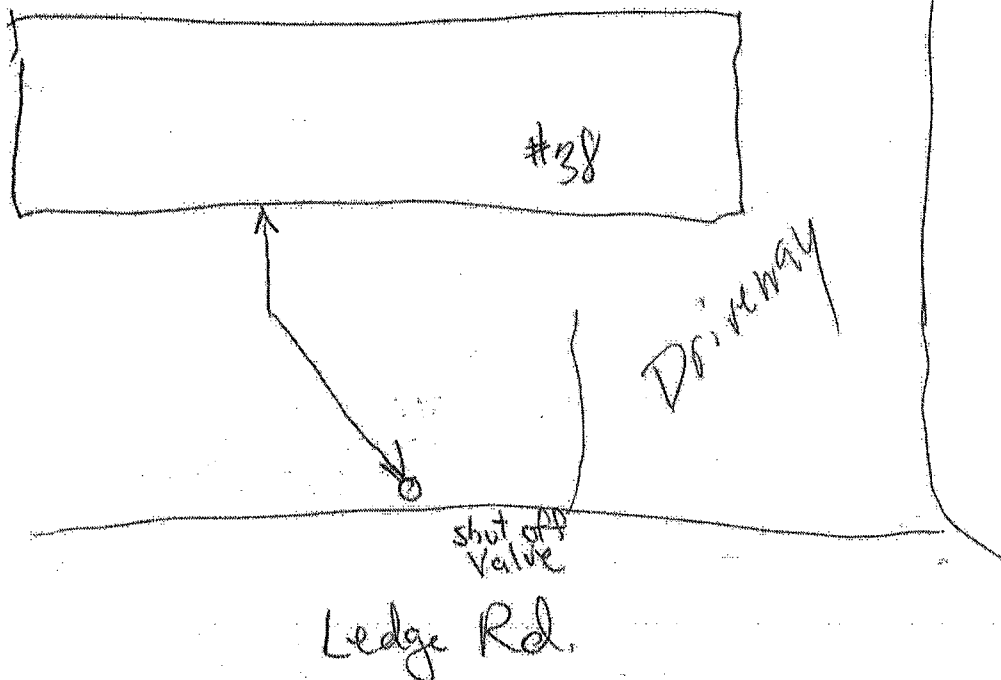

Connection to Building

The applicant shall provide proper plumbing of building(s), which shall be in compliance with the International Plumbing Code as well as the Rules and Ordinances of the Town of Seabrook and the State of New Hampshire. Water lines are required to be inspected by the Water Department before backfilling.

-OFFICE USE ONLY-

GRANTED _____ DENIED _____ DATE _____

Board of Water Commissioners

REASON FOR DENIAL: _____

(Chairman)

Water Superintendent

8/18/25
Date

AMOUNT PAID

50.00

DATE RECEIVED

1377

DATE RECEIVED

8/18/25

BY