



TOWN OF SEABROOK PUBLIC WATER SYSTEM

550 Route 107 ~ PO Box 456, Seabrook, NH 03874

Phone: (603) 474-9921 Fax: (603) 474-3399

WATER SERVICE APPLICATION


APPLICANT INFO SAME AS LANDOWNER? ☒ YES ☐ NO		DATE 09 / 29 / 2025	
APPLICANT NAME/CORPORATION RMH NH LLC		LANDOWNER/BILLING NAME	
APPLICANT ADDRESS 319 Rte. 107	HOME/WORK PHONE	BILLING ADDRESS	HOME/WORK PHONE
CITY/STATE Seabrook, NH	ZIP CODE 03874	CITY/STATE	ZIP CODE
E-MAIL ADDRESS OF APPLICANT DGuerin@Eurekanh.com	WORK/OTHER PHONE	E-MAIL ADDRESS OF LANDOWNER	WORK/OTHER PHONE

SERVICE ADDRESS: 319 Rte. 107	ASSESSOR'S MAP-LOT-SEC 10/42/
TYPE OF CONSTRUCTION: (Check All That Apply)	
NEW CONSTRUCTION RESIDENTIAL SINGLE FAMILY MULTI-FAMILY CONDO	
MOBILE/MANUFACTURED HOME ☒ COMMERCIAL INDUSTRIAL (Please Describe)	
*UNDER 'ADDITIONAL COMMENTS' SECTION, LIST NO. OF BUILDINGS AND NO. OF UNITS IN EACH BUILDING, IF APPLICABLE	

NO. OF STORIES IN BUILDING: 1	BUILDING SIZE IN SQUARE FEET: 160	TOTAL PARCEL AREA IN SQUARE FEET:
FIRE DEPARTMENT REQUIREMENTS NONE	SPRINKLE ALL	SPRINKLE GARAGE ONLY
FIRE HYDRANTS REQUIRED NONE	PUBLIC (NO. OF HYDRANTS)	PRIVATE (NO. OF HYDRANTS)
IS THERE A WELL ON THE PROPERTY? YES NO	USING RECYCLED WATER? YES NO	
WILL A PUMP BE USED TO BOOST PRESSURE? YES - FIRE SERVICE YES - DOMESTIC SERVICE NO		
WILL THERE BE LANDSCAPE IRRIGATION? YES NO	IF YES, NUMBER OF SPRINKLER HEADS:	
FLOW OF EACH SPRINKLER HEAD IN GPM:	TOTAL IRRIGATED AREA IN SQUARE FEET:	
IF NON-RESIDENTIAL, DESCRIBE BUSINESS TYPE OR USAGE OF LOT.		

SERVICES - LIST ALL REQUIRED PER PARCEL					
POTABLE OR RECYCLED	SERVICE USE (RESIDENTIAL, FIRE, IRRIGATION, ETC.)	LATERAL SIZE	METER SIZE	MAX DEMAND IN GPM	ANTICIPATED DATE OF METER INSTALLATION
potable	residential	-	5/8"	-	-

FIXTURE UNIT COUNT - COMPLETE THE QUANTITY OF THE FOLLOWING				
BATHROOM:		KITCHEN:	LAUNDRY ROOM:	MISC/OTHER:
TUBS/SHOWERS	JACUZZI TUBS	DISHWASHERS	CLOTHES WASHERS	HOSE/BIBS
TUBS ONLY	TOILETS 4	SINKS	SINKS	BAR SINKS
SHOWERS ONLY	URINALS		# OF BEDROOMS:	POOL (SIZE)
SINKS 4	BIDETS			DESCRIBE

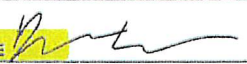LAND OWNER'S SIGNATURE  DATE 10/1/25

By signing above, I agree I will not hold the Seabrook Water Department responsible for any damages to my property, which may be incurred during, or as a result of the water installation.

**ALSO: THIS APPLICATION WILL EXPIRE 2 YEARS AFTER APPROVAL BY THE BOARD OF SELECTMEN and THE FEE WILL BE NONREFUNDABLE

CORPORATION NAME OFFICER'S NAME & TITLE (PRINT)

APPLICANT/CORPORATION'S OFFICER SIGNATURE  DATE 10/1/25

ACCOUNT#



TOWN OF SEABROOK PUBLIC WATER SYSTEM

550 Route 107 ~ PO Box 458, Seabrook, NH 03874

Phone: (603) 474-9921 Fax: (603) 474-3399


WATER SERVICE APPLICATION

Service Connection Ties

Address: 319 Rt 107

Please provide a sketch of the service connection with the approximate length. Please indicate the name of the street and a sketch of the house. In addition, please show the approximate distances from any sewer lines on the property.

If new construction, please attach a copy of plans

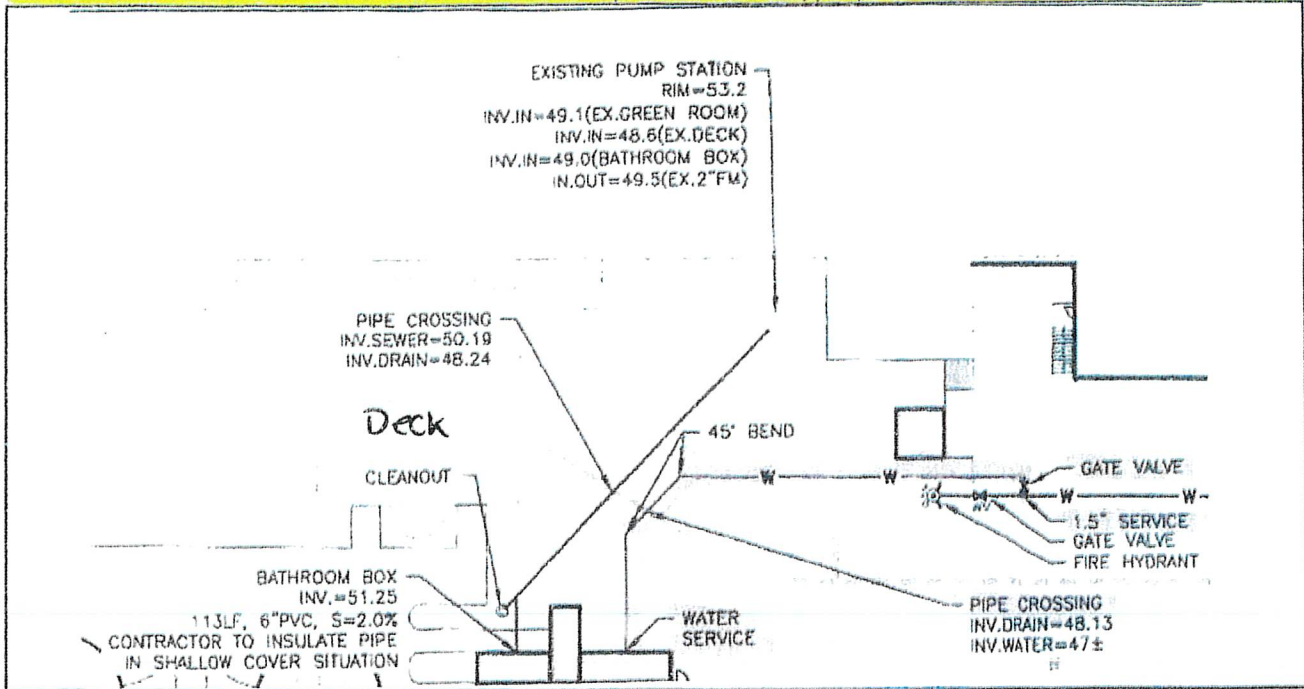

Connection to Building

***The applicant shall provide proper plumbing of building(s), which shall be in compliance with the International Plumbing Code as well as the Rules and Ordinances of the Town of Seabrook and the State of New Hampshire.

Water lines are required to be inspected by the Water Department before backfilling.***

-OFFICE USE ONLY-

GRANTED ____ DENIED ____ DATE ____

Board of Water Commissioners

REASON FOR DENIAL: _____

(Chairman)

[Signature]
Water Superintendent

10/13/25
Date

AMOUNT PAID: \$10,082.50

CASH/CHECK # 21447

DATE RECEIVED 10/13/25

BY MS