



TOWN OF SEABROOK PUBLIC WATER SYSTEM

550 Route 107 ~ PO Box 456, Seabrook, NH 03874

Phone: (603) 474-9921 Fax: (603) 474-3399

WATER SERVICE APPLICATION

APPLICANT INFO SAME AS LANDOWNER? ☒ YES ☐ NO		DATE: <u>10 16 25</u>	
APPLICANT NAME/CORPORATION: <u>Russell Eaton Sr</u>		LANDOWNER/BILLING NAME:	
APPLICANT ADDRESS: <u>44A Daws Lane</u>		BILLING ADDRESS:	
HOME/WORK PHONE:		HOME/WORK PHONE:	
CITY/STATE: <u>Seabrook NH</u>	ZIP CODE: <u>03874</u>	CITY/STATE:	ZIP CODE:
WORK/OTHER PHONE: <u>603 234 1364</u>		WORK/OTHER PHONE:	
E-MAIL ADDRESS OF APPLICANT: <u>Russell Eaton Jr @Yahoo.com</u>		E-MAIL ADDRESS OF LANDOWNER:	

SERVICE ADDRESS: <u>44A Daws Lane</u>	ASSESSOR'S MAP-LOT-SEQ: <u>12-9-1</u>
TYPE OF CONSTRUCTION: (Check All That Apply)	
☒ MOBILE/MANUFACTURED HOME	☐ NEW CONSTRUCTION
☐ COMMERCIAL	☐ RESIDENTIAL
☐ INDUSTRIAL	☐ SINGLE FAMILY
☐ MULTI-FAMILY	
☐ CONDO	
(Please Describe): <u>Double wide trailer/new line</u>	
*UNDER 'ADDITIONAL COMMENTS' SECTION, LIST NO. OF BUILDINGS AND NO. OF UNITS IN EACH BUILDING, IF APPLICABLE	

NO. OF STORIES IN BUILDING: <u>1</u>	BUILDING SIZE IN SQUARE FEET: <u>120</u>	TOTAL PARCEL AREA IN SQUARE FEET: _____
FIRE DEPARTMENT REQUIREMENTS	NONE	SPRINKLE ALL
FIRE HYDRANTS REQUIRED	NONE	SPRINKLE GARAGE ONLY
IS THERE A WELL ON THE PROPERTY?	YES	NO
WILL A PUMP BE USED TO BOOST PRESSURE?	YES - FIRE SERVICE	YES - DOMESTIC SERVICE
WILL THERE BE LANDSCAPE IRRIGATION?	YES	NO
FLOW OF EACH SPRINKLER HEAD IN GPM: _____	TOTAL IRRIGATED AREA IN SQUARE FEET: _____	
IF NON-RESIDENTIAL, DESCRIBE BUSINESS TYPE OR USAGE OF LOT: _____		

SERVICES - LIST ALL REQUIRED PER PARCEL					
POTABLE OR RECYCLED	SERVICE USE (RESIDENTIAL, FIRE, IRRIGATION, ETC.)	LATERAL SIZE	METER SIZE	MAX DEMAND IN GPM	ANTICIPATED DATE OF METER INSTALLATION
potable	residential	-	5/8"	-	-

FIXTURE UNIT COUNT - COMPLETE THE QUANTITY OF THE FOLLOWING					
BATHROOM:		KITCHEN:		LAUNDRY ROOM:	
TUBS/SHOWERS: <u>1</u>	JACUZZI TUBS: <u>1</u>	DISHWASHERS: <u>1</u>	CLOTHES WASHERS: <u>1</u>	MISC/OTHER:	
TUBS ONLY: <u>1</u>	TOILETS: <u>2</u>	SINKS: <u>1</u>	SINKS: <u>1</u>	HOSEBIBS: <u>1</u>	BAR SINKS: <u>1</u>
SHOWERS ONLY: <u>1</u>	URINALS: <u>1</u>		# OF BEDROOMS: <u>3</u>	POOL (SIZE: _____)	DESCRIBE: _____
SINKS: <u>2</u>	BIDETS: <u>1</u>				

LAND OWNER'S SIGNATURE: <u>Russell Eaton Sr</u>	DATE: <u>10-6-25</u>
By signing above, I agree I will not hold the Seabrook Water Department responsible for any damages to my property, which may be incurred during, or as a result of the water installation.	
**ALSO: THIS APPLICATION WILL EXPIRE 2 YEARS AFTER APPROVAL BY THE BOARD OF SELECTMEN and THE FEE WILL BE NONREFUNDABLE	

CORPORATION NAME	OFFICER'S NAME & TITLE (PRINT)
APPLICANT/CORPORATION'S OFFICER SIGNATURE	DATE

ACCOUNT # 051760



TOWN OF SEABROOK PUBLIC WATER SYSTEM

550 Route 107 ~ PO Box 456, Seabrook, NH 03874

Phone: (603) 474-9921 Fax: (603) 474-3399

WATER SERVICE APPLICATION


Service Connection Ties

Address:

44 A Dows Lane

Please provide a sketch of the service connection with the approximate length. Please indicate the name of the street and a sketch of the house. In addition, please show the approximate distances from any sewer lines on the property.

If new construction, please attach a copy of plans

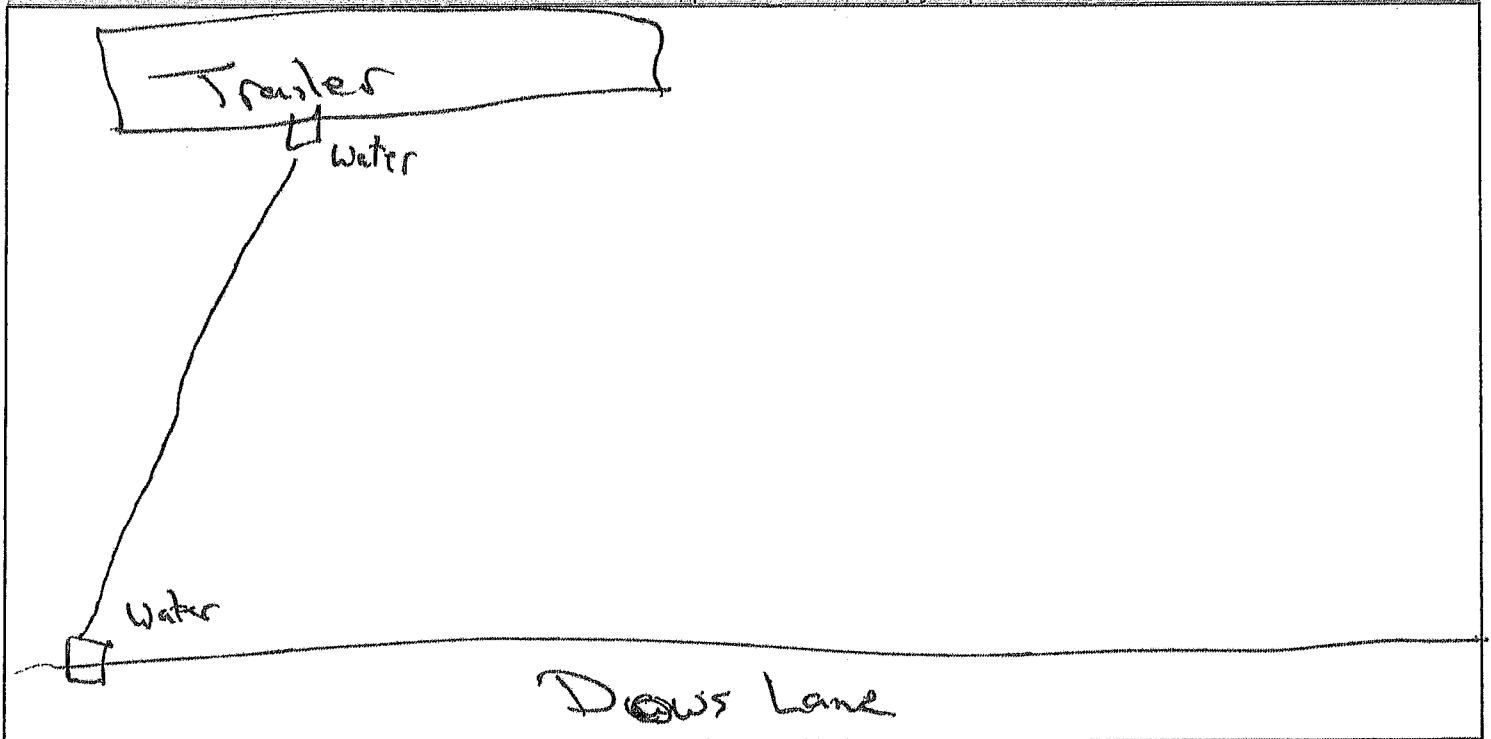

Connection to Building

***The applicant shall provide proper plumbing of building(s), which shall be in compliance with the International Plumbing Code as well as the Rules and Ordinances of the Town of Seabrook and the State of New Hampshire.

Water lines are required to be inspected by the Water Department before backfilling.***

-OFFICE USE ONLY-

GRANTED ____ DENIED ____ DATE ____

Board of Water Commissioners

REASON FOR DENIAL: _____

(Chairman)

Cutler 10/7/25
Water Superintendent

Date

AMOUNT PAID: \$100

CASH/CHECK: C

DATE RECEIVED: 10/6/25

BY: MS