

TOWN OF SEABROOK
SEWER DEPARTMENT &
WASTEWATER TREATMENT FACILITY
 PO BOX 456 • WRIGHT'S ISLAND • SEABROOK, NH 03874
 PHONE (603) 474-8012 • FAX (603) 474-8014



APPLICATION FOR SEWER SERVICE

DATE: _____

9/29/25

APPLICANT / BUSINESS NAME RMH NH LLC

SERVICE ADDRESS 319 Rte. 107

MAP 2 LOT 41 SEQ. _____ ZONING DISTRICT _____ IS LOT IN CURRENT USE? Y N

MAILING ADDRESS 319 New Zealand Rd. CITY Seabrook STATE NH ZIP 03874

PHONE 603-657-0412 CELL 603-657-0412 EMAIL DGuerin@eurekanh.com

PROPERTY OWNER (IF DIFFERENT THAN ABOVE) _____

PHONE _____

TYPE OF CONSTRUCTION (CHECK ALL THAT APPLY):

NEW CONSTRUCTION _____ RESIDENTIAL SINGLE-FAMILY _____ RESIDENTIAL MULTI-FAMILY _____

CONDO _____ MOBILE/MANUFACTURED HOME _____ COMMERCIAL ☒ INDUSTRIAL _____

OTHER (PLEASE DESCRIBE): _____

BUILDING SIZE (IN SQUARE FEET) 160

COMMENTS (IF APPLICABLE PLEASE LIST NO. OF BUILDINGS AND NO. OF UNITS):

FIXTURE COUNT

BATHROOM		KITCHEN		LAUNDRY		Misc	
SHOWER/TUB COMBO	☐	SINKS	☐	SINKS	☐	WASHING MACHINE	☐
BATHTUB	☐	TOILETS	☐	DISHWASHER	☐	SINKS	☐
SHOWER	☐	URINALS	☐	OTHER	☐	OTHER	☐
OVERSIZED BATHTUB (EX: JACUZZI, SOAKER)	☐	BIDET	☐				

PROPERTY OWNER SIGNATURE _____

DATE: _____

APPLICANT / CORPORATION OFFICER SIGNATURE _____

DATE: _____

CORPORATION NAME: RMH NH LLC

OFFICERS NAME & TITLE (print) _____

I, Daniel Guerin agree that I will not hold the Seabrook Sewer Department responsible for any damages to my property, which may be incurred during, or as a result of the sewer service installation.

Property Owner (print)

Property Owner or Agent with Power of Attorney (Signature)

AMOUNT PAID _____ CASH / CHECK # _____ DATE RECEIVED _____ BY _____

TOWN OF SEABROOK
SEWER DEPARTMENT &
WASTEWATER TREATMENT FACILITY
 PO BOX 456 • WRIGHT'S ISLAND • SEABROOK, NH 03874
 PHONE (603) 474-8012 • FAX (603) 474-8014



House Service Connection Ties


Address: 319 Rte. 107

Map: 2

Lot: 41

Seq:

Please provide a sketch of the service connection with the approximate length. Please indicate the name of the street and a sketch of the house. In addition please show the approximate distances from any water lines on the property:

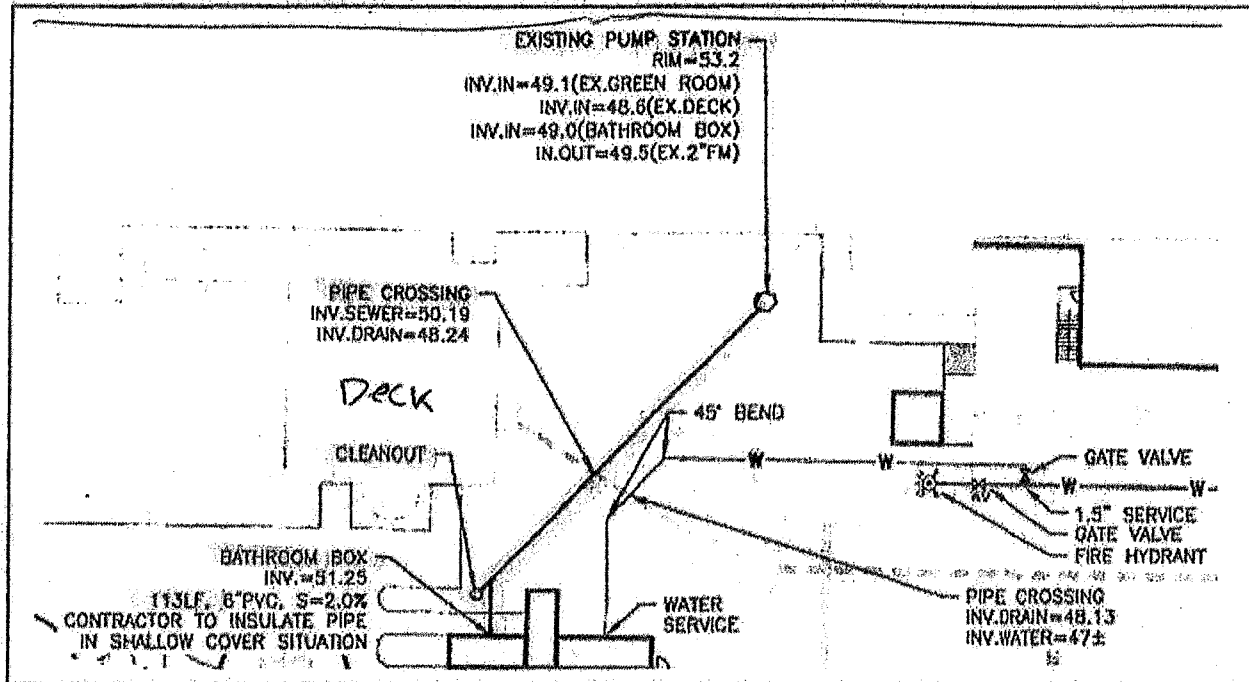

Connection to Building

The applicant shall provide proper plumbing of building(s), which shall be in compliance with the International Plumbing Code as well as the rules and ordinances of the Town of Seabrook and the State of New Hampshire. The Town of Seabrook shall inspect and certify the plumbing, including the underground piping (before backfilling), prior to connection to the Town of Seabrook's sewer system.

--OFFICE USE ONLY--

GRANTED _____ DENIED _____ DATE _____

Board of Sewer Commissioners

REASON FOR DENIAL: _____

(CHAIRMAN)

[Signature]
 Sewer Superintendent

10/13/25
 Date

AMOUNT PAID 14570.50 CASH / CHECK # 21444 DATE RECEIVED 10/13/25 BY _____

RMH NH LLC

275 MESA BLVD
MESQUITE, NV 89027

BANK OF AMERICA
MESQUITE, NEVADA 89024
94-7211224

21444

VOID AFTER 90 DAYS 10/9/2025

**\$14,570.50

PAY

Fourteen Thousand Five Hundred Seventy And 50/100

TO THE
ORDER
OF

TOWN OF SEABROOK
PO Box 476
SEABROOK, NH 03874

Sewer Department



⑆02444⑆ ⑆22400724⑆ 50104719824⑆

RMH NH LLC

275 MESA BLVD
MESQUITE, NV 89027

BANK OF AMERICA
MESQUITE, NEVADA 89024
94-7211224

21443

VOID AFTER 90 DAYS 10/9/2025

**\$10,082.50

PAY

Ten Thousand Eighty two And 50/100

TO THE
ORDER
OF

TOWN OF SEABROOK
PO Box 476
SEABROOK, NH 03874

Water Department



⑆02444⑆ ⑆22400724⑆ 50104719824⑆