



TOWN OF SEABROOK PUBLIC WATER SYSTEM

550 Route 107 ~ PO Box 456, Seabrook, NH 03874

Phone: (603) 474-9921 Fax: (603) 474-3399

WATER SERVICE APPLICATION

APPLICANT INFO SAME AS LANDOWNER? YES NO

DATE: 1/1

APPLICANT NAME/CORPORATION: J.P. KAROS Plumbing and Heating

APPLICANT ADDRESS: 25 Webster Rd

CITY/STATE: Hampton NH ZIP CODE: 03826 HOME/WORK PHONE: 978 857 6434

WORK/OTHER PHONE:

E-MAIL ADDRESS OF APPLICANT: Karosmechanical@aol.com

LANDOWNER/BILLING NAME: Josh Sarav

BILLING ADDRESS: 14 Sarav Dr

CITY/STATE: Seabrook NH ZIP CODE: 03874 HOME/WORK PHONE:

WORK/OTHER PHONE:

E-MAIL ADDRESS OF LANDOWNER:

SERVICE ADDRESS: 14 Sarav Dr

ASSESSOR'S MAP LOT-SEQ:

TYPE OF CONSTRUCTION (Check All That Apply):

NEW CONSTRUCTION

RESIDENTIAL

SINGLE FAMILY

MULTI-FAMILY

CONDO

MOBILE/MANUFACTURED HOME

COMMERCIAL

INDUSTRIAL

(Please Describe)

Emergency Line Repair

*UNDER 'ADDITIONAL COMMENTS' SECTION, LIST NO. OF BUILDINGS AND NO. OF UNITS IN EACH BUILDING, IF APPLICABLE

NO. OF STORIES IN BUILDING: 2 BUILDING SIZE IN SQUARE FEET: 1400 TOTAL PARCEL AREA IN SQUARE FEET:

FIRE DEPARTMENT REQUIREMENTS: NONE SPRINKLE ALL SPRINKLE GARAGE ONLY

FIRE HYDRANTS REQUIRED: NONE PUBLIC (NO. OF HYDRANTS) PRIVATE (NO. OF HYDRANTS)

IS THERE A WELL ON THE PROPERTY? YES NO USING RECYCLED WATER? YES NO

WILL A PUMP BE USED TO BOOST PRESSURE? YES - FIRE SERVICE YES - DOMESTIC SERVICE NO

WILL THERE BE LANDSCAPE IRRIGATION? YES NO IF YES, NUMBER OF SPRINKLER HEADS:

FLOW OF EACH SPRINKLER HEAD IN GPM: TOTAL IRRIGATED AREA IN SQUARE FEET:

IF NON-RESIDENTIAL, DESCRIBE BUSINESS TYPE OR USAGE OF LOT:

SERVICES - LIST ALL REQUIRED PER PARCEL

POTABLE OR RECYCLED	SERVICE USE (RESIDENTIAL, FIRE, IRRIGATION, ETC.)	LATERAL SIZE	METER SIZE	MAX DEMAND IN GPM	ANTICIPATED DATE OF METER INSTALLATION
potable	residential	-	5/8"	-	-

FIXTURE UNIT COUNT - COMPLETE THE QUANTITY OF THE FOLLOWING

BATHROOM: TUBS/SHOWERS 2 JACUZZI TUBS TOILETS 2 URINALS BIDETS

KITCHEN: DISHWASHERS 1 SINKS 1

LAUNDRY ROOM: CLOTHES WASHERS 1 SINKS # OF BEDROOMS: 3

MISC/OTHER: HOSE BIBS 2 BAR SINKS POOL (SIZE:) DESCRIBE:

LAND OWNER'S SIGNATURE: [Signature]

DATE: 9-19-25

By signing above, I agree I will not hold the Seabrook Water Department responsible for any damages to my property, which may be incurred during, or as a result of the water installation.

*ALSO: THIS APPLICATION WILL EXPIRE 2 YEARS AFTER APPROVAL BY THE BOARD OF SELECTMEN AND THE FEE WILL BE NONREFUNDABLE

CORPORATION NAME:

OFFICER'S NAME & TITLE (PRINT):

APPLICANT/CORPORATION'S OFFICER SIGNATURE: [Signature]

DATE: 9-19-25

ACCOUNT#

044 050



TOWN OF SEABROOK PUBLIC WATER SYSTEM

550 Route 107 ~ PO Box 456, Seabrook, NH 03874

Phone: (603) 474-9921 Fax: (603) 474-3399


WATER SERVICE APPLICATION

Service Connection Ties

Address: 14 Janurin Dr Seabrook NH

Please provide a sketch of the service connection with the approximate length. Please indicate the name of the street and a sketch of the house. In addition, please show the approximate distances from any sewer lines on the property.

"If new construction, please attach a copy of plans"

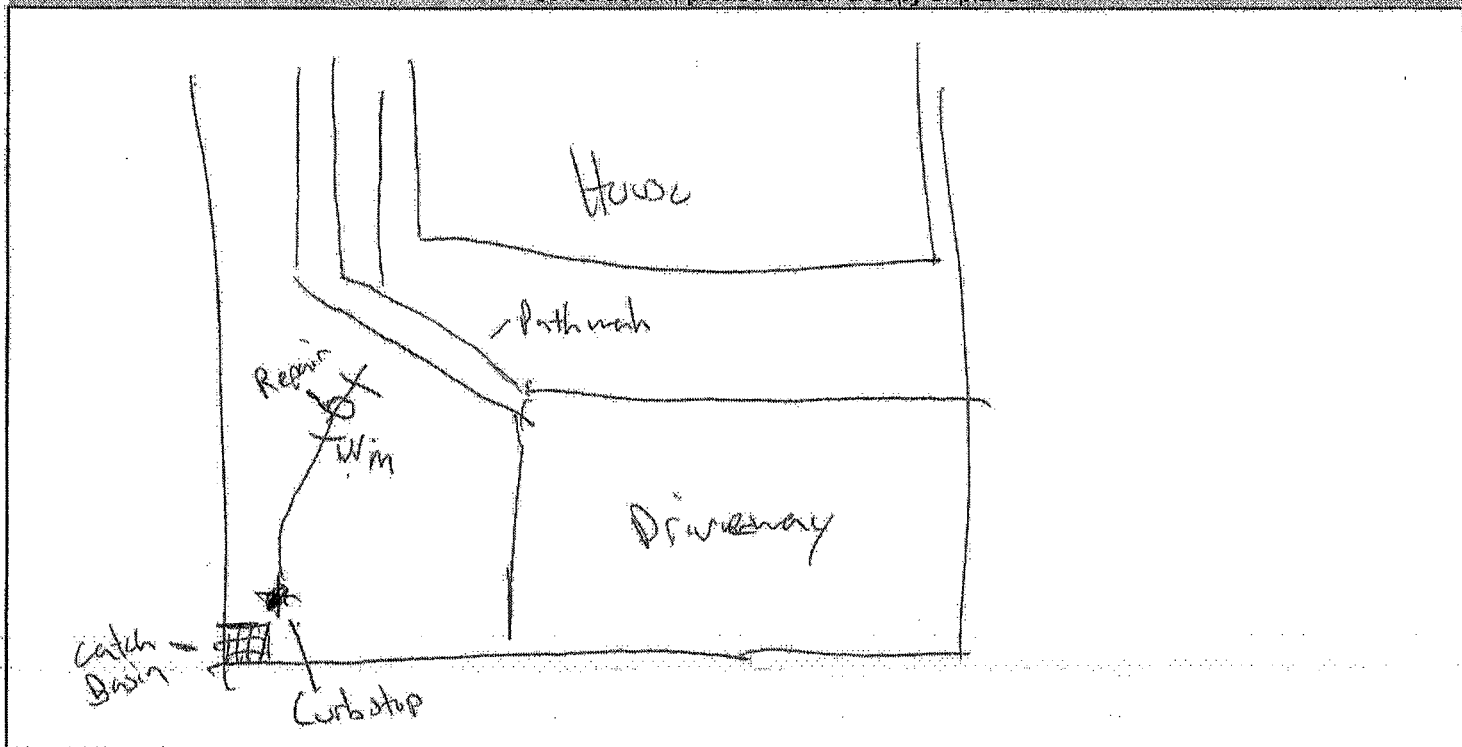

Connection to Building

The applicant shall provide proper plumbing of building(s), which shall be in compliance with the International Plumbing Code as well as the Rules and Ordinances of the Town of Seabrook and the State of New Hampshire. Water lines are required to be inspected by the Water Department before backfilling.

-OFFICE USE ONLY-

GRANTED ____ DENIED ____ DATE ____

Board of Water Commissioners

REASON FOR DENIAL: _____

(Chairman)

[Signature]
Water Superintendent

9/29/25
Date

AMOUNT PAID: 50.00

CASH/CHECK

DATE RECEIVED

9/19/25

BY

[Signature]