



TOWN OF SEABROOK PUBLIC WATER SYSTEM

550 Route 107 ~ PO Box 456, Seabrook, NH 03874
Phone: (603) 474-9921 Fax: (603) 474-3399

WATER SERVICE APPLICATION

APPLICANT INFO SAME AS LANDOWNERS

☒ YES ☐ NO

DATE:

9/16/2025

APPLICANT NAME (CORPORATION)

James W Morton 1-603-474-2813

APPLICANT ADDRESS

15 Walton Rd

HOME/WORK PHONE

1-603-474-2813

CITY/STATE

Seabrook NH

ZIP CODE

03874

WORK/OTHER PHONE

1-603-918-8080

E-MAIL ADDRESS OF APPLICANT

CJM02@comcast.net

LANDOWNERS BILLING NAME

BILLING ADDRESS

3

HOME/WORK PHONE

CITY/STATE

ZIP CODE

WORK/OTHER PHONE

E-MAIL ADDRESS OF LANDOWNER

SERVICE ADDRESS

15 Walton Rd

ASSESSOR'S MAP LOT/SEQ.

TYPE OF CONSTRUCTION

(Click All That Apply)

NEW CONSTRUCTION

RESIDENTIAL

SINGLE FAMILY

MULTI-FAMILY

CONDO

MOBILE/MANUFACTURED HOME

COMMERCIAL

INDUSTRIAL

(Please Describe)

Line Replacement

Emergency

*UNDER 'ADDITIONAL COMMENTS' SECTION, LIST NO. OF BUILDINGS AND NO. OF UNITS IN EACH BUILDING, IF APPLICABLE

NO. OF STORIES IN BUILDING:

BUILDING SIZE IN SQUARE FEET:

TOTAL PARCEL AREA IN SQUARE FEET:

FIRE DEPARTMENT REQUIREMENTS

☐ NONE

☐ SPRINKLE ALL

☐ SPRINKLE GARAGE ONLY

FIRE HYDRANTS REQUIRED

☐ NONE

☐ PUB

☐ PRIVATE (NO. OF HYDRANTS)

IS THERE A WELL ON THE PROPERTY?

☐ YES

☐ NO

USE

☐ YES

☐ NO

WEL

☐ YES

☐ Y

☐ NO

WILL THERE BE LANDSCAPE IRRIGATION?

☐ YES

☐ NO

IF YES, NUMBER OF SPRINKLER HEADS:

FLOW OF EACH SPRINKLER HEAD IN GPM:

TOTAL IRRIGATED AREA IN SQUARE FEET:

IF NON-RESIDENTIAL, DESCRIBE BUSINESS TYPE OR USAGE OF LOT:

SERVICES - LIST ALL REQUIRED PER PARCEL

POTABLE OR RECYCLED	SERVICE USE (RESIDENTIAL, FIRE, IRRIGATION, ETC.)	LATERAL SIZE	METER SIZE	MAX DEMAND IN GPM	ANTICIPATED DATE OF METER INSTALLATION
potable	residential		5/8"		

FIXTURE UNIT COUNT - COMPLETE THE QUANTITY OF THE FOLLOWING

BATHROOM:

TUBS/SHOWERS	JACUZZI TUBS
TUBS ONLY	TOILETS
SHOWERS ONLY	URINALS
SINKS	BIDS

KITCHEN:

DISHWASHERS
SINKS

LAUNDRY ROOM:

CLOTHES WASHERS
SINKS
OF BEDROOMS:

MISC/OTHER:

HOSE BIBS
BAR SINKS
POOL (SIZE):
DESCRIBE:

LAND OWNERS SIGNATURE

James W Morton

DATE

9-16-25

By signing above, I agree I will not hold the Seabrook Water Department responsible for any damages to my property, which may be incurred during, or as a result of the water installation.

*ALSO: THIS APPLICATION WILL EXPIRE 2 YEARS AFTER APPROVAL BY THE BOARD OF SELECTMEN and THE FEE WILL BE NONREFUNDABLE

CORPORATION NAME

OFFICER'S NAME & TITLE (PRINT)

APPLICANT/CORPORATION'S OFFICER SIGNATURE

[Signature]

DATE

9/16/25



072150

TOWN OF SEABROOK PUBLIC WATER SYSTEM

550 Route 107 ~ PO Box 456, Seabrook, NH 03874
Phone: (603) 474-9921 Fax: (603) 474-3399

WATER SERVICE APPLICATION


Service Connection Ties

Address:

15 Walton Rd

Please provide a sketch of the service connection with the approximate length. Please indicate the name of the street and a sketch of the house. In addition, please show the approximate distances from any sewer lines on the property.

"If new construction, please attach a copy of plans."

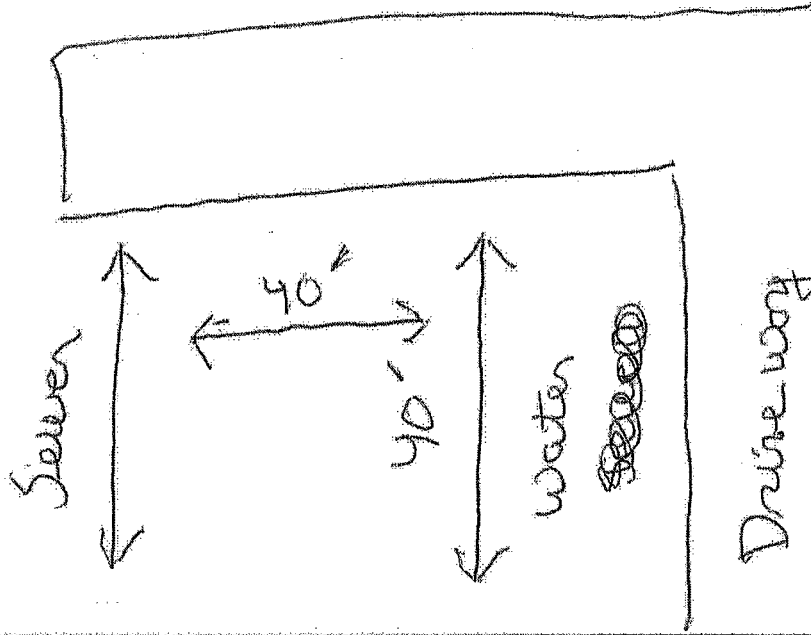

AMOUNT PAID: \$100

CASH CHECK #

90

DATE RECEIVED

9-16-25

BY

MS