

APR 3 2024

Town of Seabrook, NH

**TOWN OF SEABROOK  
LICENSE FOR AMUSEMENT DEVICE**

**Date:** \_\_\_\_\_ **Number of Devices:** 5  
**Mailing Address:** 246 S. Taylor Ave, Suite 200  
Louisville, CO 80027-3603 **FEE:** \$300.00

This license is given by the Selectmen for the Town of Seabrook, New Hampshire pursuant to the Ordinance to Regulate and License Amusement Devices and RSA 31:41-d.

**TO:** National Entertainment Network, LLC  
(Name of license holder)

**FOR:** Coin-Operated Amusement Machines - See Attached List for Details  
(Description of amusement devices)

**NAME OF BUSINESS WHERE DEVICES ARE LOCATED:** Wal-Mart #1762

to be located at: 700-F Lafayette Road  
(Address of premises)

and in accordance with the specific location as shown on the attached diagram. The amusement devices shall be operated only between the hours of 9:00 a.m. and 10:00 p.m.

I, Pat Payne - Tax Analyst, applicant for the above license, have read the Ordinance to Regulate and License Amusement Devices of the Town of Seabrook, and certify that the amusement device(s) which I wish to have licensed are not in violation of the said ordinance.

**Date:** 3-25-2024 Pat Payne  
Signature of Applicant

This license is issued subject to the following conditions:

1. License shall be valid upon the signature of two Selectmen.
2. License shall be valid only to the named license holder, for the specific devices described above, and the location and during the hours as specified above.
3. License shall be prominently posted in the area of the amusement devices so licensed.
4. License shall be valid only until December 31<sup>st</sup> of the year of its issue. Renewal shall only be by re-issuance by the Board of Selectmen and only after review and compliance with all existing regulations and requirements.
5. Licensee shall be subject to all conditions, rules and regulations as set forth in the ordinances for the town, and specifically the Ordinance to Regulate and License Amusement Devices, as well as any amendments thereto and any regulations promulgated there under.
6. The licensed amusement device shall not be used or operated or in conjunction with any type of gambling or wagering.

Approval Date: \_\_\_\_\_

**BOARD OF SELECTMEN**


\_\_\_\_\_  
\_\_\_\_\_  
\_\_\_\_\_

Recommendation of Code Enforcement Office

\_\_\_\_\_  
Lacey L Fowler, Code Enforcement Officer

(Draw floor plan of business and location of amusement device below)

Abuttier \_\_\_\_\_

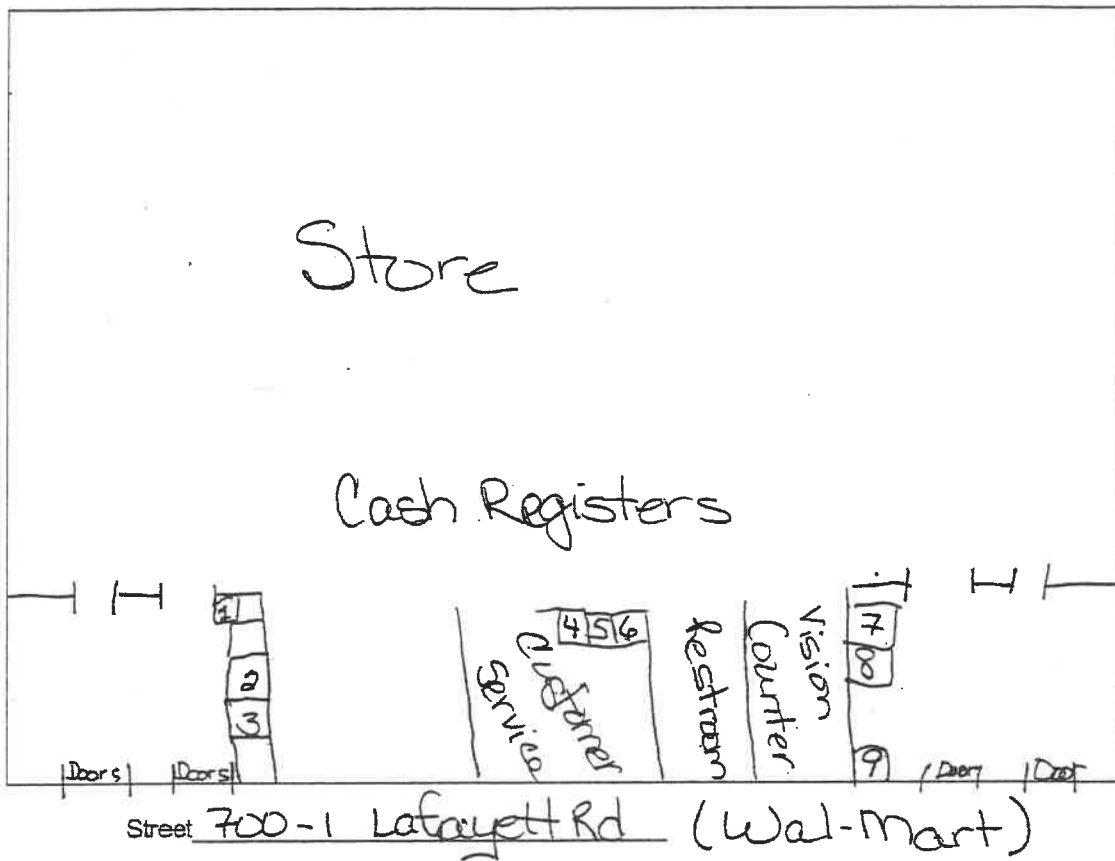

**License fees:** \$100 per year or any part thereof for a license covering from one to three amusement devices; and for each additional device shall pay \$100 per year or any part thereof, provided that the applicant may, at his discretion, remove and replace any device without further payment of fee. However, each additional or replaced device must be licensed.

- 1 - Bubble Gum Rack
- 2 - 42" Crane
- 3 - 60" Toy Crane
- 4 - Bounce Ball Vending
- 5 - Sticker Vending
- 6 - 60" Toy Crane
- 7 - 42" Treasure Crane
- 8 - 60" Toy Crane
- 9 - Bubble Gum Rack

**COIN-OPERATED MACHINES PLACED IN THE TOWN OF SEABROOK  
 NATIONAL ENTERTAINMENT NETWORK - MID-ATLANTIC**

as of: 03/25/2024

TOWN COUNTY STATE  
 SEABROOK ROCKINGHAM NH

| Mach #   | Mach Ser # | Mach Type          | Client # | Client Name    | Address              | # of Mach |
|----------|------------|--------------------|----------|----------------|----------------------|-----------|
| 00026640 | 144033     | CR BEANIE RBC 42   | WM001762 | WAL-MART #1762 | 700-1 LAFAYETTE ROAD | 1         |
| 00022976 | 126843     | CR SUPER RBC 60    | WM001762 | WAL-MART #1762 | 700-1 LAFAYETTE ROAD | 1         |
| 00024667 | 127607     | CR TOY MART RBC 60 | WM001762 | WAL-MART #1762 | 700-1 LAFAYETTE ROAD | 1         |
| 00042395 | 129436     | CR TOY MART RBC 60 | WM001762 | WAL-MART #1762 | 700-1 LAFAYETTE ROAD | 1         |
| 00041998 | 144990     | CR TREAS RBC 42    | WM001762 | WAL-MART #1762 | 700-1 LAFAYETTE ROAD | 1         |

**TOTAL AMUSEMENT MACHINES / FEES**

5

\$ 100.00

\$ 200.00

\$ 300.00

1-3 Machines is \$100

\$100.00 Each additional

TOWN TOTAL